


CERTIFIED RECORD OF LAND CORNER MONUMENTATION

**History of original corner establishment:** Corner originally ESTABLISHED by John Hagel, U.S. Deputy Mineral Surveyor, under instructions dated June 30, 1902, for the Amazon Group of Quartz Claims, Mineral Survey No 480.

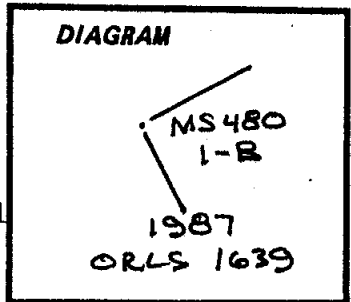

Surveyor General records state: Begining at Cor No 1 Brooklyn Lode. Identical with the NW cor of the location, set a black pine post 8 ins square 4 ft long 12 ins in the ground scribed BRO.C.1-480 with a mound of rocks around it. A black pine tree 8 ins in diam brs N5<sup>o</sup>E, 10.3 ft. A black pine tree 10 ins in diam brs N46<sup>o</sup>30W, 9.8 ft. Both blazed and scribed BRO.C.1-480 BT.

Corner REMONUMENTED by L.L. Myers, ORLS 699, in 1970 as described in his record filed with the Baker County Surveyor (No. 9-36-7), on Aug. 31, 1977, which states: "I found a rock mound with a small stake marking the corner. The original post was gone as were the bearing trees. Set a 5/8" x 30" rebar with a 2" aluminum cap in the rock mound marked as shown above. This survey did not tie to the range line and section corner as the original did."

**Description of corner evidence found:**

No trace of original accessory BTs.

5/8x30" rebar with 1 1/2" aluminum cap per record of Baker County Survey Nos. 9-36-7 & 9-37-15 and marked as shown to right:



**Description of monument and accessories I established to perpetuate the original location of this corner:**

At position of rebar with 1 1/2" aluminum cap...

Removed rebar and replaced with 2"x30" aluminum pipe with 2 1/2" aluminum cap 25" in ground and surrounded with a mound of earth and stone. Cap marked as shown in corner diagram. Set 6' steel fence post alongside with signs 54-2 & 54-9 attached. Drove rebar below ground surface alongside aluminum cap.

**New bearing trees established:**

A western larch 16" diam brs N61 1/2<sup>o</sup>W, 47.2' dist mkd B-1-480 BT.  
 A western larch 16" diam brs S24 1/2<sup>o</sup>W, 43.6' dist mkd B-1-480 BT.


New bearing trees have a brass washer stamped PLS 1639 nailed to face of blaze. Attached signs 54-3 & 54-9 and painted face of blaze and 6" band of red paint around each BT.

Compass declination 20<sup>o</sup> East.

I hereby certify that the above corner monument was properly REMONUMENTED to U.S.F.S. standards by me and witnessed by Bill Gohring on December 7, 1987.



*William L. Hanley*

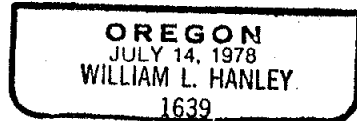

Office of.....County Surveyor.....County of Baker.....  
 State of.....Oregon....., I hereby certify that the within instrument was filed in this office for record on the..... day of....., 19.....  
 ..... by .....  
 (COUNTY OFFICIAL) (DEPUTY)

FILED 2-18-88  
 BAKER COUNTY SURVEYOR  
 SURVEY NO. 9-37-146