


CERTIFIED RECORD OF LAND CORNER MONUMENTATION

History of original corner establishment: Corner ESTABLISHED by John Hagel, U.S. Deputy Mineral Surveyor, under instructions dated June 30, 1902, for the Amazon Group of Quartz Claims, Mineral Survey No. 480. Surveyor General records state: To Cor No 3 of the Brooklyn Lode, identical with SE cor of the location. Identical with Cor No 4 of the Amazon Lode. Identical with Cor No 2 of the Cupid Lode of this survey. Set a pine post 5 ins square 4½ ft long 18 ins in ground scribed BRO.C.3-AMA.C.4-CUP.C.2-SUR.480 with mound of rock around. A tamarack tree 8 ins diam blazed and scribed BRO.C.3-480-BT bears S31°0'E, 20.2 ft. A red fir tree 11 ins diam blazed & scribed AMA.C.4-480-BT bears S84°20'W, (no distance in original record). A red fir tree 10 ins diam blazed and scribed CUP.C.2-480-BT bears S82°30'W, 44.5 ft.

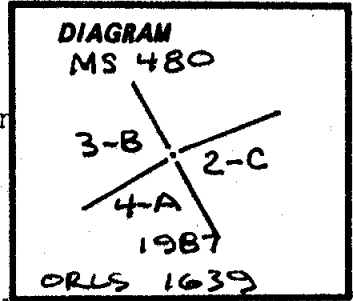

Corner REMONUMENTED by L.L. Myers, ORLS 699, in 1970 as described in his record filed with the Baker County Surveyor (No. 9-37-17), on Aug. 31, 1977, which states: "Found rock mound & post with scribing. The 8" tamarack BT is gone. The 10" red fir might be there, did not have no for this BT while doing the work, but it may be a white fir. There is a white fir tree with

Description of corner evidence found: blaze scar of appropriate size & direction to be the 11" red fir BT. It is 3 ft from the rock mound. Set a 5/8"x30" rebar with a 2" aluminum cap in center of the rock mound for the corner. John Mitchell had placed a BT tag on the suspected

No evidence of wood post as described by L.L. Myers.

Found a 1½" aluminum cap on 5/8"x30" steel rebar, in surrounding rock mound. Aluminum cap marked as shown to right, per record of Baker County Survey No. 9-37-17.



OBT: A sawed douglas fir stump 24" dia brs S86°W (record, S82°30'W), 44.5' dist per record, no evidence of scribing as described by L.L. Myers: A douglas fir 27" dia with fully healed blaze brs N64°W, 3.0' dist (record, S84°20'W, no distance).

Description of monument and accessories established to perpetuate the original location of this corner:

At position of rebar with 1½" aluminum cap...

Removed rebar monument and replaced with 2"x30" aluminum pipe with 2½" aluminum cap 25" in ground and surrounded with rock mound. Cap marked as shown in corner diagram. Set 6' steel fence post alongside with signs 54-2 and 54-9 attached. Drove rebar below ground surface alongside aluminum cap.

New bearing tree established;
A ponderosa pine 12" diam brs S58°E, 44.9' dist mkd A-4-B-3-C-2-480 BT.

New bearing trees have a brass washer marked PLS 1639 nailed to face of blaze. Attached signs 54-3 & 54-9 and painted face of blaze and 6" band of red paint around each bearing tree.

Compass declination 20° East.

I hereby certify that the above corner monument was properly REMONUMENTED to U.S.F.S. standards by me and witnessed by Bill Gohring on October 26, 1987.

**REGISTERED
PROFESSIONAL
LAND SURVEYOR**

William L. Hanley

**OREGON
JULY 14, 1978
WILLIAM L. HANLEY
1639**

Office of.....County Surveyor..... County of... Baker.....
Oregon
State of....., I hereby certify that the within instrument was filed in this office
for record on the..... day of....., 19.....
..... by

(COUNTY OFFICIAL)

(DEPUTY)

FILED 2-18-88

BAKER COUNTY SURVEYOR

SURVEY NO. 9-37-147