


CERTIFIED RECORD OF LAND CORNER MONUMENTATION

History of original corner establishment: Corner originally ESTABLISHED by John Hagel, U.S. Deputy Mineral Surveyor, under instructions dated June 30, 1902, for the Amazon Group of Quartz Claims, Mineral Survey No. 480.

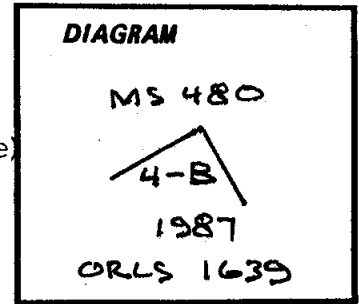

Surveyor General records state: To Cor No 4 (of the Brooklyn Lode) Identical with the NE cor of the location. Set a white fir post 5 ins square 4 1/2 ft long 12 ins in ground scribed BRO.C.4-480 with a mound of rocks around it. A white fir tree 14 ins diam bears N76°W, 49.1 ft. A white fir tree 12 ins diam bears N88°W, 49.7 ft, both blazed and scribed BRO.C.4-480 BT.

Corner REMONUMENTED by L.L. Myers, ORLS 699, in 1970 as described in his record filed with the Baker County Surveyor (No. 9-37-18), on Aug 31, 1977, which states: "Found the rock mound and two douglas fir bearing trees which have grown to about 24". The 14" BT has been broken off and is now a stub about 6' high. I set a 5/8" x 30" rebar with a 2" aluminum cap marked as shown above in the center of the rock mound for the corner. John Mitchell had placed bearing tree tags on the two BT.

Description of corner evidence found:

A 1 1/2" aluminum cap on 5/8" x 30" steel rebar with earthen mound with a 4"x4"x24" wood post alongside mkd: COR 4 B on two faces, COR 2 on another face and C/6 on the other face aluminum cap per Baker County Survey No 9-37-18, and marked as shown to right, from which:



OBT: A 30" white fir with fully healed blaze brs N85°W. 50.5' dist (record, N76°W, 49.1' dist).

A 24" white fir wind blown snag 6' long with fragmentary remains of scribing BRO 4 480 BT on partially healed blaze brs N74°W, 49.4' dist (record, N88°W, 49.7' dist).

Description of monument and accessories I established to perpetuate the original location of this corner:

At position of rebar with 1 1/2" aluminum cap... Removed rebar monument and replaced with 2" x 30" aluminum pipe with 2 1/2" aluminum cap 25" in ground and surrounded with rock mound. Cap marked as shown in corner diagram. Set 6' steel fence post alongside with signs 54-2 and 54-9 attached. Drove rebar below ground surface alongside aluminum cap.


New bearing trees established:

A ponderosa pine 11" diam brs S42°E, 39.3' dist mkd B-4-480 BT.

New bearing trees have a brass washer stamped PLS 1639 nailed to face of blaze. Attached signs 54-3 & 54-9 and painted face of blaze and 6" band of red paint around each BT.

Compass declination 20° East.

I hereby certify that the above corner monument was properly REMONUMENTED to U.S.F.S. standards by me and witnessed by Bill Gohring on October 26, 1987.

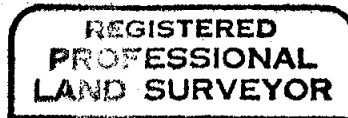

William L. Hanley



Office of.....County Surveyor..... County of.....Baker.....
State of.....Oregon....., I hereby certify that the within instrument was filed in this office
for record on the..... day of....., 19.....
..... by
(COUNTY OFFICIAL) (DEPUTY)

FILED 2-18-88
BAKER COUNTY SURVEYOR
SURVEY NO. 9-37-148