


CERTIFIED RECORD OF LAND CORNER MONUMENTATION

Corner 2, Amazon Lode, M.S. 480.

History of original corner establishment:

Corner originally ESTABLISHED by John Hagel under instructions dated June 30, 1902, for the Amazon Group of quartz claims mineral survey No. 480.

Surveyor General records state: To Cor No 2. Identical with the SW cor of the location. Set a black pine post 5 ins square 4½ ft long 18 ins in the ground scribed AMA.C2-480 with a mound of rocks around it. A tamarack tree 24 ins in diam blazed and scribed AMA.C2-480-BT bears S88°05'W, 8.5 ft.

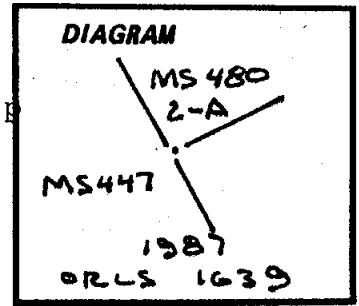

Corner RECOVERED by J.R. Mitchell, experienced corner recovery technician, in October, 1970, and he placed sign 54-3 on OBT.

Description of corner evidence found:

No trace of original corner post or rock mound.

A 24" western larch snag with partially healed blaze mkd AMA C 2 480 BT brs S88°05'W, 8.5' dist per record.

Description of monument and accessories established to perpetuate the original location of this corner:

At position determined by reversed record bearing and distance from original BT...

Set 2" x 30" aluminum pipe with 2½" aluminum cap 25" in ground and surrounded with a mound of earth and stone. Cap marked as shown in corner diagram. Set 6' steel fence post alongside with signs 54-2 and 54-9 attached.

New bearing trees established:

A lodgepole pine 12" dia brs S49°E, 33.6' dist mkd A-2-480 BT.
A lodgepole pine 16" dia brs N60½°E, 51.9' dist mkd A-2-480 BT.

New bearing trees have a brass washer stamped PLS 1639 nailed to face of blaze. Attached signs 54-3 & 54-9 and painted face of blaze and 6" band of red paint around each BT.

Compass declination 20° East.

I hereby certify that the above corner monument was properly REMONUMENTED to U.S.F.S. standards by me and witnessed by Bill Gohring on October 23, 1987.

REGISTERED
PROFESSIONAL
LAND SURVEYOR

William L. Hanley

OREGON
JULY 14, 1978
WILLIAM L. HANLEY
1639

Office of.....County Surveyor..... County of...Baker.....

State of.....Oregon....., I hereby certify that the within instrument was filed in this office for record on the..... day of....., 19.....

..... by
(COUNTY OFFICIAL) (DEPUTY)

FILED 2-18-88
BAKER COUNTY SURVEYOR
SURVEY NO. 9-37-151