


CERTIFIED RECORD OF LAND CORNER MONUMENTATION

**History of original corner establishment:**

Corner ESTABLISHED by C.M.Foster, U.S.Deputy Mineral Surveyor, under instructions dated September 6, 1888, for mineral survey no. 177, the Mountain Belle Quartz Mine. Surveyor General records state: Mound of rocks and post marked Mountain Belle Claim Sta.No.4.Sur No.177.

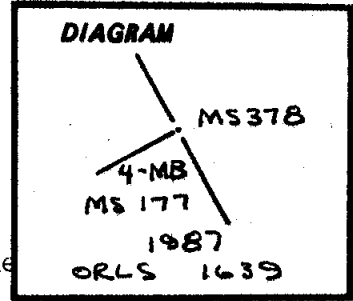


Corner RECOVERED by John Hagel, U.S.Deputy Mineral Surveyor, under instructions dated October 19, 1899, for the survey of the Wide West Lode, a portion of MS 378. Surveyor General records state: Cor.No.4 of the Mountain Belle Lode, Sur 177 bears S29°43'E, 1.5 ft.

Corner RECOVERED & PERPETUATED by J.R.Mitchell, experienced corner recovery technician, as noted below. No record filed with Baker County Surveyor.

**Description of corner evidence found:**

Found a 2½" brass cap on 1" galvanized iron pipe with surrounding rock mound and wood post with fragmentary scribes laying alongside, brass cap marked as shown to the right, from which:

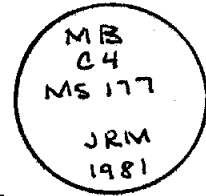

JRM BT: A 14" douglas fir with partially healed blaze brs S74½°W, 9.0' dist mkd MS 177 BT.

ADDITIONAL: A 2½" brass cap on a 1" galvanized iron pipe with surrounding rock mound by JRM brs N29°43'W, 1.5' dist per record for corner No. 1, Wide West Lode, M.S. 378. (See my corner certification for this corner filed simultaneously which supports this corner position)

NOTE: No determination made as to originality of recovered wood post remains.

**Description of monument and accessories I established to perpetuate the original location of this corner:**

At position of JRM brass cap monument...

Removed brass cap monument & replaced with a 2" x 30" aluminum pipe with 2½" aluminum cap 25" in ground, surrounded with mound of earth & stone. Cap marked as shown in corner diagram. Set 6' steel fence post alongside with sign 54-9 & 54-2 attached.

New bearing tree established:

A lodgepole pine 6" dia brs N25°E, 68.8' dist mkd MB-4-177 BT.

New bearing trees have a brass washer stamped PLS 1639 nailed to face of blaze. Attached signs 54-3 & 54-9 and painted face of blaze and 6" band of red paint around each BT.

Compass declination 20° East.

I hereby certify that the above corner monument was properly REMONUMENTED to U.S.F.S. standards by me and witnessed by Bill Gohring on November 24, 1987.

REGISTERED  
PROFESSIONAL  
LAND SURVEYOR

*William L. Hanley*

OREGON  
JULY 14, 1978  
WILLIAM L. HANLEY  
1639

Office of.....County Surveyor..... County of...Baker.....  
State of.....Oregon....., I hereby certify that the within instrument was filed in this office  
for record on the..... day of....., 19.....

..... by .....  
(COUNTY OFFICIAL) (DEPUTY)

FILED 2-18-88

BAKER COUNTY SURVEYOR

SURVEY NO. 9-37-153

8-37-121