


CERTIFIED RECORD OF LAND CORNER MONUMENTATION

West End Center, Mountain Belle Lode, MS 177, East End Center, Cupid Lode, MS 480

History of original corner establishment:

Corner ESTABLISHED by C.M.Foster, U.S. Deputy Mineral Surveyor, under instructions dated September 6, 1888, for the survey of the Mountain Belle Quartz Mine, MS 177. Surveyor General records state: (No record in official notes.... see next paragraph.)

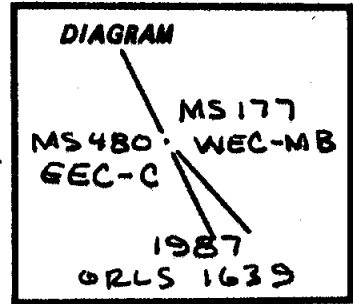

Corner RECOVERED and AMMENDED by John Hagel under instructions dated June 30, 1902, for the Amazon Group of Quartz Claims, Mineral Survey No. 480. Surveyor General records state: Identical with the point of discovery, identical with the end center of the Mountain Belle Lode M Sur No 117. Found a fir post 4 ins square 3 1/2 ft above ground scribed SW END MOUNTAIN BELLE. Set a black pine post 6 ins square 4 1/2 ft long along scribed CUP.E.CEN.S.480 with mound of rocks around it. A yellow pine tree 37 ins dia scribed CUP.E.CEN.S.480-BT brs N36°E, 53.3 ft. Mouth of cut No 8 brs N61°45'W, 15.5 ft. Centre of shaft No 9 brs S62°35'W, 58.7 ft. Mouth of tunnel brs S0°35'W, 53.4 ft.

Description of corner evidence found:

Found a rock mound with remains of rotten wood in center from which...

A large decaying ponderosa pine wind blow stub and remaining root hole brs N36°E, 53.3' dist per record. Stub is 40" diam.

Additional recovery supporting this corner position are: Mouth of cut, center of shaft and other tunnel location per record.

Description of monument and accessories | established to perpetuate the original location of this corner:

At position of center of rock mound...

Set 2" x 30" aluminum pipe with 2 1/2" aluminum cap 25" in ground and surrounded with a mound of earth and stone. Cap marked as shown in corner diagram. Set 6' steel fence post alongside with signs 54-9 attached.

New bearing trees established:

A lodgepole pine 11" dia brs S57°W, 26.4' dist mkd MB-WEC-177-C-EEC-480 BT.
A lodgepole pine 15" dia brs S75°E, 29.1' dist mkd MB-WEC-177-C-EEC-480 BT.

New bearing trees have a brass washer stamped PLS 1639 nailed to face of blaze. Attached signs 54-3 & 54-9 and painted face of blaze and 6" band of red paint around each BT.

Compass declination 20° East.

I hereby certify that the above corner monument was properly REMONUMENTED to U.S.F.S. standards by me and witnessed by Bill Gohring on December 24, 1987.

REGISTERED PROFESSIONAL LAND SURVEYOR

William L. Hanley

OREGON JULY 14, 1978 WILLIAM L. HANLEY 1639

Office of.....County Surveyor..... County of Baker.....
State of Oregon....., I hereby certify that the within instrument was filed in this office for record on the..... day of....., 19.....

..... by
(COUNTY OFFICIAL) (DEPUTY)

FILED 2-18-88
BAKER COUNTY SURVEYOR
SURVEY NO. 9-37-154