


CERTIFIED RECORD OF LAND CORNER MONUMENTATION

History of original corner establishment:

Corner ESTABLISHED by John Hagel U.S. Deputy Mineral Surveyor, under instructions dated October 19, 1899, for the survey of the Century Lode, a portion of MS 378. Surveyor General records state: To Cor No 4 (of the Century Lode). Set a white fir post 4 ins square 4½ ft long 18 ins in ground with a mound of rocks around it, marked Century C.4-378. A white fir tree 10 ins diam bears N61°15'E, 64.0 ft. A white fir tree 8 ins diam bears S63°E, 30.5 ft. Both blazed and marked Century C.4-378 BT.

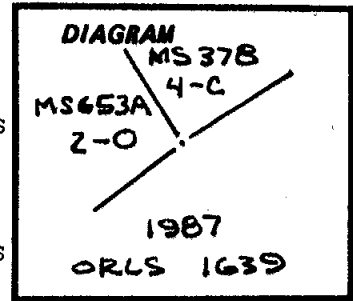

Corner RECOVERED & AMMENDED by Wm.W.Elmer, U.S. Deputy Mineral Surveyor, under instructions dated November 28, 1905, for the survey of the Orleans Quartz Mining Claim, MS 653 A. Surveyor General records state: Cor No 2 (of the Orleans Lode), identical with Cor No 4, Sur No 378, Century Lode, a post 5 ins square set in ground with mound of earth & stone scribed Centy.C-4-378, 2-653A Or., whence a fir 16 ins dia bears N85°22'W, 7.85 ft. A pine 6 ins dia bears S38°42'E, 40.20 ft, both blazed and scribed 2-653 A.,OR. BT.

Description of corner evidence found:

Corner RECOVERED & PERPETUATED by J.R.Mitchell, experienced corner recovery technician, as noted below. No record filed with Baker County Surveyor.

Found a JRM 2½" brass cap on 1" galvanized iron pipe with surrounding rock mound and rotting pieces of wood with fragmentary scribe marks, brass cap marked as shown to right, from which: OBT: A white fir 22" dia with fully healed blaze brs N63½°E, 43.4' dist (record, N61°15'E, 64.0' dist). A white fir 20" dia with fully healed blaze brs S60½°E (record, S63°E), 30.5' dist per record. A white fir 29" dia with fully healed blaze brs N85°22'W, 7.85' dist per record. No trace of other MS 653 A BT. JRM BT: A white fir 11" dia with partially healed blaze brs N10½°W, 37.0' dist mkd CEN 4 MS 378 BT.



Description of monument and accessories I established to perpetuate the original location of this corner:

At position of JRM brass cap monument... Removed brass cap monument & replaced with a 2" x 30" aluminum pipe with 2½" aluminum cap 25" in ground, surrounded with mound of earth & stone. Cap marked as shown in corner diagram. Set 6' steel fence post alongside with sign 54-9 & 54-2 attached.

No new bearing trees established.

Painted 6" band of red paint around each OBT & JRM BT, also painted blaze & attached signs 54-3 & 54-9 to all BTs.

Compass declination 20° East.

I hereby certify that the above corner monument was properly REMONUMENTED to U.S.F.S. standards by me and witnessed by Bill Gohring on November 9, 1987.

REGISTERED
PROFESSIONAL
LAND SURVEYOR
William L. Hanley
OREGON
JULY 14, 1978
WILLIAM L. HANLEY
1639

Office of..... County Surveyor..... County of Baker
State of Oregon....., I hereby certify that the within instrument was filed in this office
for record on the..... day of....., 19.....
..... by
(COUNTY OFFICIAL) (DEPUTY)

FILED 2-18-88
BAKER COUNTY SURVEYOR
SURVEY NO. 9-37-155
8-37-122