


**CERTIFIED RECORD OF LAND CORNER MONUMENTATION**

**History of original corner establishment:** Corner ESTABLISHED by John Hagel U.S. Deputy Mineral Surveyor, under instructions dated October 19, 1899, mineral survey no. 378, the Century Lode, a portion of MS 378. Surveyor General records state: To Cor No 3. Identical with the NW location Cor. Set a fir post 4 ins square, 4½ ft long 18 ins in ground with mound of rocks around it, marked Century C.3-378. A white fir tree 10 ins diam bears N43°35'W, 35.0 ft. A white fir tree 8 ins diam bears N38°45'W, 36.0 ft. Both blazed and marked Century C.3-378 B.T.

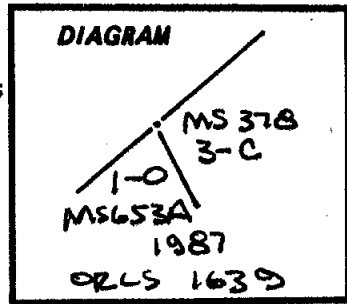

Corner RECOVERED & AMENDED by Wm.W.Elmer, U.S.Deputy Mineral Surveyor, under instructions dated November 28, 1905, mineral survey No 653 A, for the Orleans Quartz Mineral Claim. Surveyor General records state; Beginning at Cor.No.1(Orleans Lode) identical with Cor. No.3,Sur.No.378, Century Lode, a post 6 ins square, set in the ground with a mound of earth and stone, scribed Centy.C.3,378,1-653 A.Or., whence the N.E. cor of Sec.6,T.9 S.R.37E.,W.M., bears N80°47'E, 1930.55 ft., Cor No.3 Sur.No.177, Mountain Belle Lode, a post 4 ins square set in ground with a mound of earth and stone, scribed Moun. Belle, Sta.No.3,Sur.No.19, bears N29°27'W, 7.20 ft., Cor.No.4,Sur.No.378, Wide West Lode, a post 4 ins square set in ground with mound of earth and stone, scribed W.West,C-4-378, bears N55°13'E, 26.30 ft., a fir 6 ins dia blaz

**Description of corner evidence found:** and scribed, 1-653-A.Or.BT., bears N43°17'W, 17.42 ft. Corner RECOVERED & PERPETUATED by J.R.Mitchell, experienced corner recover technician. No record filed with the Baker County Surveyor of his perpetu of the corner as described below.

Found a 2½" brass cap on 1" galvanized iron pipe with surrounding rock mound, brass cap marked as shown to the right, from which...

Cor.No. 4 Wide West Lode, MS 378, brs N55°13'E, 26.3 ft. dist per record and Cor.No. 3 Mountain Belle Lode, MS 177, brs N29°27'W, 7.2 ft dist per record, each perpetuated with a 2½" brass cap on 1" galvanized iron pipe



NOTE: These corners were remonumented concurrently and a certified record of land corner monumentation has been prepared for each.

OBT: A white fir 30" dia with fully healed blaze brs N43°35'W, 35.0' dist per record. A dead white fir snag with fully healed blaze brs N38°45'W, 36.0' dist per record.

JRM BT: A white fir 7" dia with partially healed blaze brs S69°W, 13.8' dist mkd CEN 3 MS 378 BT, with 1" overgrowth.

**Description of monument and accessories established to perpetuate the original location of this corner:**

At position of JRM brass cap monument...

Removed brass cap monument and replaced with a 2" x 30" aluminum pipe with 2½" aluminum cap 25" in ground and surrounded with a mound of earth and stone. Cap marked as shown in corner diagram. Set 6' steel fence post alongside with signs 54-2 & 54-9 attached.

No new bearing trees established.

Attached signs 54-3 and 54-9 and painted face of blaze and 6" band of red paint around each original and JRM BT.

Compass declination 20° East.

I hereby certify that the above corner monument was properly REMONUMENTED to U.S.F.S. standards by me and witnessed by Bill Gohring on November 20, 1987.

**REGISTERED  
PROFESSIONAL  
LAND SURVEYOR**

*William L. Hanley*

**OREGON  
JULY 14, 1978  
WILLIAM L. HANLEY  
1639**

Office of.....County..Surveyor..... County of...Baker.....  
State of.....Oregon....., I hereby certify that the within instrument was filed in this office  
for record on the..... day of....., 19.....

..... by .....

(COUNTY OFFICIAL)

(DEPUTY)

FILED 2-18-88  
BAKER COUNTY SURVEYOR  
SURVEY NO. 9-37-156  
8-37-123