


CERTIFIED RECORD OF LAND CORNER MONUMENTATION

History of original corner establishment:

Corner ESTABLISHED by Wm.W.Elmer, U.S.Deputy Mineral Surveyor, under instructions dated November 28, 1905, for the survey of the Orleans Quartz Mining Claim, MS 653 A. Surveyor General records state: Cor No 4 (Orleans Lode), a pine post 4 ins square, 4 ft long set 1 1/2 ft in ground with mound of earth and stone, scribed 4-653 A. Or., whence a pine 6 ins dia bears S42°15'W, 15.65 ft, a pine 8 ins dia bears S22°26'E, 20.10 ft, both blazed and scribed 4-653 A Or. BT. Cor No 1 Orleans Mill Site bears S47°33'W, 5 ft.

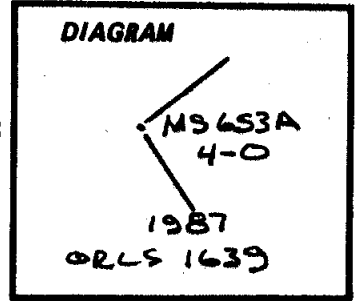

Description of corner evidence found:

Found a 1 1/2" x 30" long steel pipe projecting 3" above the ground in surrounding rock mound, origin unknown, from which:

- OBT: A lodgepole pine 13" dia with partially healed blaze mkd 1-653B ORMBT & 4 653A ORBT brs S22°26'E, 20.10' dist per record.
- A lodgepole pine 9" dia with partially healed blaze mkd A OR BT & 653 B OR M BT brs S42°15'W, 15.65' dist per record.
- Additionally, a lodgepole pine 20" dia with previously opened blaze with face axed over and fragmentary scribe marks remaining brs S65°E, 12.2'(no record of this tree).

Description of monument and accessories established to perpetuate the original location of this corner:

At position of 1 1/2" dia steel pipe...

Removed 1 1/2" dia steel pipe & replaced with a 2" x 30" aluminum pipe with 2 1/2" aluminum cap 25" in ground, surrounded with mound of earth & stone. Cap marked as shown in corner diagram. Set 6' steel fence post alongside with signs 54-2 & 54-9 attached. Buried original pipe inside aluminum pipe.

No new bearing trees established.

Painted 6" band of red paint around each original BT, also painted blaze r attached signs 54-3 & 54-9 to all BTs.

Compass declination 20° East.

I hereby certify that the above corner monument was properly REMONUMENTED to U.S.F.S. standards by me and witnessed by Bill Gohring on December 28, 1987.

REGISTERED
PROFESSIONAL
LAND SURVEYOR

William L. Hanley

OREGON
JULY 14, 1978
WILLIAM L. HANLEY
1639

Office of..... County Surveyor..... County of... Baker.....
State of..... Oregon....., I hereby certify that the within instrument was filed in this office
for record on the..... day of....., 19.....

..... by
(COUNTY OFFICIAL) (DEPUTY)

FILED 2-18-88
BAKER COUNTY SURVEYOR
SURVEY NO. 9-37-157