


CERTIFIED RECORD OF LAND CORNER MONUMENTATION

History of original corner establishment:

Corner ESTABLISHED by Ira L. Hoffman, U.S. Deputy Mineral Surveyor, under instructions dated July 12, 1911, for the survey of Silver Dick and Blue Swan Quartz Mining Claims, MS 745.

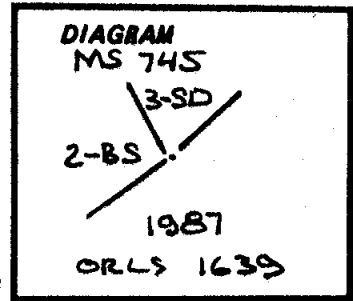

Surveyor General records state: To cor. No.3. (Silver Dick Lode identical with cor. No.2 Blue Swan Lode) A pine post 4 1/2 ft. long, 5 ins. square, set 2 ft. in the ground, with mound of earth, scribed S.D.-3-745 & B.S.-2- from which, Location cor. post common to the Silver Dick and Blue Swan Lodes bears S30°38'E, 10 ft. dist. A pine 6 ins. in diam. bears N15°12'W, 5.9 ft. dist., scribed S.D.3-745, & B.S.-2-745-B.T. A pine 8 ins in diam. bears S79°28'E, 9.3 ft. dist. scribed S.D.-3-745 & B.S.-2-745, B.T.

Corner RECOVERED & PERPETUATED by J.R. Mitchell, experienced corner recovery technician, as noted below. No record filed with Baker County Surveyor.

Description of corner evidence found:

A steel fence post projecting above ground 3.2' with a 3"x3"x2' wood post alongside scribed "COR 2" on one side and "COR" on other side surrounded by rock mound, from which:
OBT: A lodgepole pine wind-blow 8" dia brs N15°12'W, 5.9' dist as per record with partially healed blaze mkd "SD 3 745". A lodgepole pine wind-blow 10" dia brs S79°28'E, 9.3' dist as per record, with partially healed blaze mkd "BS 2 745".
JRM BT: A lodgepole pine 6" dia brs N48°W, 4.9' dist with partially healed blaze mkd "COR 2". A lodgepole pine 6" dia brs S26°E, 8.0' dist with partially healed blaze mkd "COR 2".

Description of monument and accessories established to perpetuate the original location of this corner:

At position of wood post and steel fence post in center of rock mound...
Removed wood post and steel fence post and replaced with a 2" x 30" aluminum pipe with 2 1/2" aluminum cap 25" in ground surrounded with a mound of earth and stone. Cap marked as shown in corner diagram. Set 6' steel fence post alongside with signs 54-2 & 54-9 attached. Laid wood post alongside mound.
No new bearing trees established.
Attached signs 54-3 & 54-9 and painted face of blaze and 6" band of red paint around each original and JRM BT.

Compass declination 20° East.

I hereby certify that the above corner monument was properly REMONUMENTED to U.S.F.S. standards by me and witnessed by Bill Gohring on November 11, 1987.

REGISTERED
PROFESSIONAL
LAND SURVEYOR

William L. Hanley

OREGON
JULY 14, 1978
WILLIAM L. HANLEY
1639

Office of.....County Surveyor..... County of...Baker.....
State of.....Oregon....., I hereby certify that the within instrument was filed in this office
for record on the..... day of....., 19.....

..... by
(COUNTY OFFICIAL) (DEPUTY)

FILED 2-18-80
BAKER COUNTY SURVEYOR
SURVEY NO. 9-37-160