


CERTIFIED RECORD OF LAND CORNER MONUMENTATION

History of original corner establishment:

Corner ESTABLISHED by Ira L. Hoffman, U.S. Deputy Mineral Surveyor, under instructions dated July 12, 1911, for the survey of Silver Dick and Blue Swan Quartz Mining Claims, MS 745.

Surveyor General records state: To Cor.No.3.(Blue Swan Lode) A fir post 4½ ft. long, 5 ins.square, set 2 ft.in the ground,with a mound of earth,scribed B.S.-3-745, from which: Location S/W. cor post bears S30°38'E, 5 ft dist. A tamarack 24 ins. in diam bears S42°42'W, 17.7 ft dist. scribed B.S.-3-745-B.T.

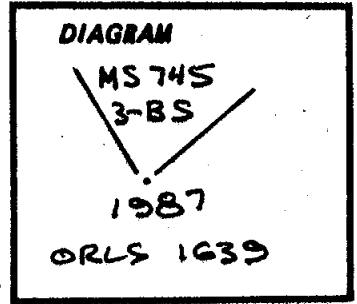

Description of corner evidence found:

No trace of original wood post.

OBT: A sawed & rotting western larch 20" dia with 4' stump and split blaze mkd "BS 3 745 BT".

Description of monument and accessories established to perpetuate the original location of this corner:

At position determined by reversed record bearing & distance from recovered BT...

Set 2" x 30" aluminum pipe with 2½" aluminum cap 25" in ground and surrounded with a mound of earth & stone. Cap marked as shown in corner diagram. Set 6' steel fence post alongside, and attached signs 54-9 & 54-2.

New bearing trees established:

A lodgepole pine 6" dia brs S29½°E, 12.3'dist mkd BS-3-745 BT.
A lodgepole pine 8" dia brs N76°W, 30.5'dist mkd BS-3-745 BT.

New bearing trees have a brass washer marked PLS 1639 nailed to face of blaze. Attached signs 54-3 & 54-9 and painted face of blaze and 6" band of red paint around each bearing tree.

Compass declination 20° East.

I hereby certify that the above corner monument was properly REMONUMENTED to U.S.F.S. standards by me and witnessed by Bill Gohring on November 18, 1987.

REGISTERED
PROFESSIONAL
LAND SURVEYOR

William L. Hanley

OREGON
JULY 14, 1978
WILLIAM L. HANLEY
1639

Office of..... County Surveyor..... County of..... Baker.....
State of..... Oregon....., I hereby certify that the within instrument was filed in this office
for record on the..... day of....., 19.....
..... by
(COUNTY OFFICIAL) (DEPUTY)

FILED 2-18-88
BAKER COUNTY SURVEYOR
SURVEY NO. 9-37-161