


CERTIFIED RECORD OF LAND CORNER MONUMENTATION

Cor.No.2,Mountain Belle Lode, MS 177.

History of original corner establishment:

This corner was ESTABLISHED in 1888 by C.M.Foster, U.S. deputy mineral surveyor, as follows:

To post and mound of rocks marked Mountain Belle Claim Sta.No.2.Sur No.177.

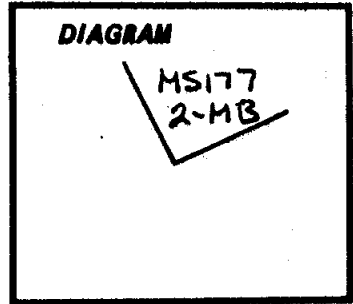


Description of corner evidence found:

None.

Description of monument and accessories I established to perpetuate the original location of this corner:

At position determined by survey (see Record of Survey Plat filed separately for method of corner position reestablishment)...

Set 2" x 30" aluminum pipe with 2 1/2" dia aluminum cap attached 25" in ground surrounded with a mound of earth & stone and placed 6' steel fence post alongside with signs 54-9 & 54-2 attached. Aluminum cap marked as shown to the right...

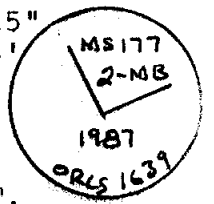

New bearing trees established:

A lodgepole pine 7" diam brs S40 1/2° W, 12.0' dist mkd MB-2-177 BT.
A lodgepole pine 10" diam brs S02° E, 28.8' dist mkd MB-2-177 BT.

Each new bearing tree has signs 54-3 & 54-9 attached below a surrounding 6" band of red paint and has a brass washer marked PLS 1639 nailed flush to red painted blaze.

Compass declination 20° East.

I hereby certify that the above described corner was REESTABLISHED and MONUMENTED to USFS standards by me and witnessed by Bill Gohring on December 29, 1987. . .

**REGISTERED
PROFESSIONAL
LAND SURVEYOR**

William L. Hanley

**OREGON
JULY 14, 1978
WILLIAM L. HANLEY
1639**

Office of..... County Surveyor..... County of..... Baker.....

State of..... Oregon....., I hereby certify that the within instrument was filed in this office

for record on the..... day of....., 19.....

..... by

(COUNTY OFFICIAL)

(DEPUTY)

FILED 5-2-88
BAKER COUNTY SURVEYOR
SURVEY NO. 9-37-164