


CERTIFIED RECORD OF LAND CORNER MONUMENTATION

West center end Brooklyn Lode MS 480.

History of original corner establishment:

Corner ESTABLISHED by John Hagel, U.S. Deputy Mineral Surveyor, under instructions dated June 30, 1902, for the Amazon Group of Quartz Claims, Mineral Survey No. 480.

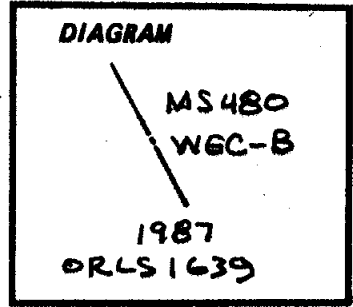

Surveyor General records state: To West end center Brooklyn Lode, identical with the point of discovery. Set a black pine post 7 ins square 4½ ft long 24 ins in ground scribed BRO.W.CEN-S 480 with a mound of earth around it. A spruce tree 7 ins in diam blazed and scribed BRO.W.CEN.S.480 BT brs S49°0'W, 9.8 ft.

Description of corner evidence found:

No trace of original pine post.

A spruce 14" diam with "W" scribed inside a 5" overgrowth, opened this survey. (Record states BT bears S49°00'W, 9.8' from corner.)

Description of monument and accessories established to perpetuate the original location of this corner:

At position determined by reversed record bearing and distance from recovered BT...

Set 2" x 30" aluminum pipe with 2½" aluminum cap 25" in ground and surrounded with a mound of earth, no stones. Cap marked as shown in corner diagram. Set 6' steel fence post alongside, and attached signs 54-9 & 54-2.

New bearing trees established:

A western larch 19" diam brs N20°W, 69.2' dist mkd B-WEC-480 BT.
A spruce 10" diam brs S36°W, 46.2' dist mkd B-WEC-480 BT.

New bearing trees have a brass washer marked PLS 1639 nailed to face of blaze. Attached signs 54-3 & 54-9 and painted face of blaze and 6" band of red paint around each bearing tree.

Compass declination 20° East.

I hereby certify that the above corner monument was properly REMONUMENTED to U.S.F.S. standards by me and witnessed by Bill Gohring on December 7, 1987.

REGISTERED
PROFESSIONAL
LAND SURVEYOR

William L. Hanley

OREGON
JULY 14, 1978
WILLIAM L. HANLEY
1639

Office of.....County Surveyor..... County of...Baker.....
State of.....Oregon....., I hereby certify that the within instrument was filed in this office
for record on the..... day of....., 19....

..... by
(COUNTY OFFICIAL) (DEPUTY)

FILED 5-2-88
BAKER COUNTY SURVEYOR
SURVEY NO. 9-37-166