


CERTIFIED RECORD OF LAND CORNER MONUMENTATION

Cor.No.3, Orleans Lode, MS 653 A.

History of original corner establishment:

This corner ESTABLISHED in 1905 by Wm.W.Elmer, U.S. deputy mineral surveyor, as follows:

Cor.No.3, a pine post 4½ ins square 4 ft long set 1½ ft in the ground with a mound of earth and stone, scribed 3-653-A., Of., whence a pine 8 ins dia, bears S83°55'W., 37.65 ft., a pine 6 ins dia., bears, N.1°15'W., 39.30 ft, both blazed and scribed 3-653 A. Or.B.T. Cor.No.2 Orleans Millsite bears S47°33'W, 5 ft.

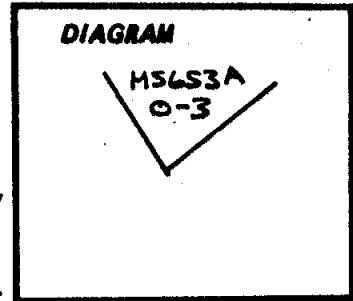

Description of corner evidence found:


Corner post not found on edge of old Silver Creek roadway.

A lodgepole pine 13" diam brs S84½°E, 38.9' dist(record: S83°55'W, 37.65') from reestablished corner point mkd 3653AOR BT & 2653BORM BT on same blaze. The corner position relative to this apparent official BT was thouroughly evaluated by considering possible bearing letter transpositions because the blaze is on the opposite side of tree per record. The tree was rejected because no positioning of the corner relative to it conformed to the record notes & plat. It is noted that the scribes on a tree near Cor.No.4 of this claim had previously been axed out - probably to correct some error discovered during the official survey of this claim. The tree was recorded & tagged as an official bearing tree to the reestablished corner point per the recovered position above noted.

Description of monument and accessories I established to perpetuate the original location of this corner:

At position determined by survey (see Record of Survey Plat filed separately for method of corner position reestablishment)...

Set 2" x 30" aluminum pipe with 2½" dia aluminum cap attached 25" in ground surrounded with a mound of earth & stone and placed 6' steel fence post alongside with signs 54-9 & 54-2 attached. Aluminum cap marked as shown to the right...

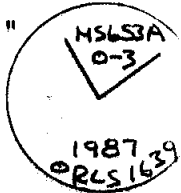

New bearing tree established:

A lodgepole pine 7" diam brs S36°E, 13.0' dist mkd O-3-653A BT.

Each bearing tree has signs 54-3 & 54-9 attached below a surrounding 6" band of red paint. New bearing tree has a brass washer marked PLS 1639 nailed flush to red painted blaze.

Compass declination 20° East.

I hereby certify that the above described corner was REESTABLISHED and MONUMENTED to USFS standards by me and witnessed by Bill Gohring on December 28, 1987.

REGISTERED PROFESSIONAL LAND SURVEYOR

William L. Hanley

OREGON
JULY 14, 1978
WILLIAM L. HANLEY
1639

Office of...County Surveyor..... County of...Baker.....

State of...Oregon....., I hereby certify that the within instrument was filed in this office

for record on the..... day of....., 19.....

..... by
(COUNTY OFFICIAL) (DEPUTY)

FILED 5-2-88

BAKER COUNTY SURVEYOR

SURVEY NO. 9-37-168