


CERTIFIED RECORD OF LAND CORNER MONUMENTATION

Cor.No.1, Orleans Mill Site, MS 653 B.

**History of original corner establishment:**

This corner ESTABLISHED in 1905 by Wm.W.Elmer, U.S. deputy mineral surveyor, as follows:

Beginning at Cor.No.1, a pine post 4 ins square 4 ft long set 1 1/2 ft in the ground with a mound of earth and stone, scribed 1-653-B.Or.M., whence N.E. location corner, identical with Cor.No.4, Orelens lode this survey, previously described, bears N47°33'E., 5 ft.

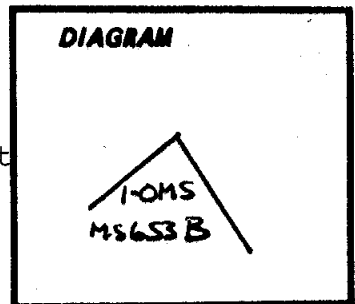

**Description of corner evidence found:**

A 20" lodgepole pine brs S83°E, 14.8' dist from reestablished corner position with previously opened blaze with face axed over & fragment scribe marks remaining (no record).


OBTs: A lodgepole pine 13" diam brs S31°E, 19.5' from reestablished corner position mkd 653BORM BT & 4653AOR BT on a partially healed blaze.

A lodgepole pine 9" diam brs S37°W, 10.4' dist from reestablished corner position mkd 653BORM BT & 653AOR BT on partially healed blaze. (no record of either of these OBTs)

**Description of monument and accessories | established to perpetuate the original location of this corner:**

At position determined by survey (see Record of Survey Plat filed separately for method of corner position reestablishment)...

Set 2" x 30" aluminum pipe with 2 1/2" dia aluminum cap attached 25" in ground surrounded with a mound of earth & stone and placed 6' steel fence post alongside with signs 54-9 & 54-2 attached. Aluminum cap marked as shown to the right...

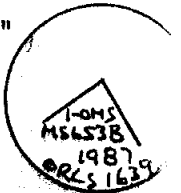

No new bearing trees established. Used old bearing trees (not of record) as recovered.

Each bearing tree has signs 54-3 & 54-9 attached below a surrounding 6" band of red paint.

Compass declination 20° East.

I hereby certify that the above described corner was REESTABLISHED and MONUMENTED to USFS standards by me and witnessed by Bill Gohring on December 28, 1987.

REGISTERED  
PROFESSIONAL  
LAND SURVEYOR

*William L. Hanley*

OREGON  
JULY 14, 1978  
WILLIAM L. HANLEY  
1639

Office of.....County Surveyor..... County of.....Baker.....

State of.....Oregon....., I hereby certify that the within instrument was filed in this office

for record on the..... day of....., 19.....

..... by .....

(COUNTY OFFICIAL)

(DEPUTY)

FILED 5-2-88

BAKER COUNTY SURVEYOR

SURVEY NO. 9-37-169