


CERTIFIED RECORD OF LAND CORNER MONUMENTATION

Cor.No.2,Silver Dick Lode, MS 745.

History of original corner establishment:

This corner ESTABLISHED in 1911 by Ira L.Hoffman, U.S. deputy mineral surveyor, as follows:

To cor.No.2. A pine post 4½ ft long 5 ins square set 2 ft in the ground with a mound of earth, scribed S.D.-2-745.,from which, Location S.E. cor post bears N48°E, 45 ft dist. A fir 4 ins diam bears N31°32'E, 10.9 ft dist, scribed S.D.-2-745.-B.T. A fir 6 ins in diam bears S30°02'W, 7.9 ft dist, scribed S.D.-2-745-B.T.

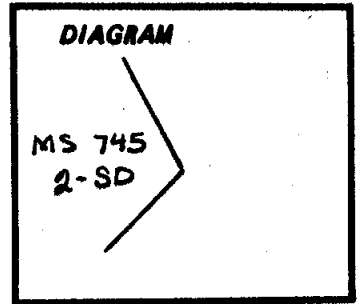

Description of corner evidence found:

A white fir 24" diam mkd with nonprofessional fragmentary scribes, brs N52°E, 70.7' dist (not original and rejected).

Description of monument and accessories I established to perpetuate the original location of this corner:

At position determined by survey (see Record of Survey Plat filed separately for method of corner position reestablishment)...

Set 2" x 30" aluminum pipe with 2½" dia aluminum cap attached 25" in ground surrounded with a mound of earth & stone and placed 6' steel fence post alongside with signs 54-9 & 54-2 attached. Aluminum cap marked as shown to the right...

New bearing trees established:

A lodgepole pine 7" diam brs N07½°E, 58.7' dist mkd SD-2-745 BT.
A lodgepole pine 8" diam brs S73°W, 103.9' dist mkd SD-2-745 BT.

Each new bearing tree has signs 54-3 & 54-9 attached below a surrounding 6" band of red paint and has a brass washer marked PLS 1639 nailed flush to red painted blaze.

Compass declination 20° East.

I hereby certify that the above described corner was REESTABLISHED and MONUMENTED to USFS standards by me and witnessed by Bill Gohring on December 18, 1987.



REGISTERED
PROFESSIONAL
LAND SURVEYOR

William L. Hanley

OREGON
JULY 14, 1978
WILLIAM L. HANLEY
1639

Office of.....County Surveyor..... County of.....Baker.....
State of.....Oregon..... I hereby certify that the within instrument was filed in this office
for record on the..... day of....., 19.....
..... by
(COUNTY OFFICIAL) (DEPUTY)

FILED 5-2-88
BAKER COUNTY SURVEYOR
SURVEY NO. 9-37-172