


CERTIFIED RECORD OF LAND CORNER MONUMENTATION

Cor.No.4, Blue Swan Lode, MS 745.

History of original corner establishment:

This corner ESTABLISHED in 1911 by Ira L.Hoffman, U.S.deputy mineral surveyor, as follows:

To cor.No.4. A fir post 4 1/2 ft long 5 ins square, set 2 ft in the ground with a mound of earth, scribed B.S.-4-745.

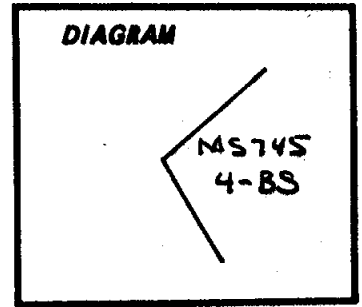

Description of corner evidence found:

No original corner post.

A spruce 20" diam brs S37°E, 77.5' dist from reestablished corner point mkd BT on previously opened blaze(no record). A sawed western larch stump 35" diam brs S54°W, 105.5' dist from reestablished corner point mkd with fragment of possible "T" scribe inside 5" overgrowth removed this date. (no record)

Description of monument and accessories I established to perpetuate the original location of this corner:

At position determined by survey (see Record of Survey Plat filed separately for method of corner position reestablishment)...

Set 2" x 30" aluminum pipe with 2 1/2" dia aluminum cap attached 25" in ground surrounded with a mound of earth & stone and placed 6' steel fence post alongside with signs 54-9 & 54-2 attached. Aluminum cap marked as shown to the right...



New bearing trees established:

A western larch 11" diam brs N47°W, 53.0' dist mkd BS-4-745 BT. A lodgepole pine 8" diam brs S58 1/2°W, 11.0' dist mkd BS-4-745 BT.

Each new bearing tree has signs 54-3 & 54-9 attached below a surrounding 6" band of red paint and has a brass washer marked PLS 1639 nailed flush to red painted blaze.

Compass declination 20° East.

I hereby certify that the above described corner was REESTABLISHED and MONUMENTED to USFS standards by me and witnessed by Bill Gohring on December 23, 1987. .

REGISTERED
PROFESSIONAL
LAND SURVEYOR

William L. Hanley

OREGON
JULY 14, 1978
WILLIAM L. HANLEY
1639

Office of.....County Surveyor..... County of...Baker.....
State of.....Oregon..... I hereby certify that the within instrument was filed in this office
for record on the..... day of....., 19.....
..... by
(COUNTY OFFICIAL) (DEPUTY)

FILED 5-2-88
BAKER COUNTY SURVEYOR
SURVEY NO. 9-37-174