

INDEX No. U-12

History of original corner establishment:

Corner established this survey.

DIAGRAM

T9S R37E
SE 1/16
S28
1991
PLS 848

Description of corner evidence found:

Corner established this survey.


Description of monument and accessories I established to perpetuate the original location of this corner:

Set 2-1/2"x30" aluminum pipe with 3-1/2" aluminum cap, stamped as shown on the DIAGRAM, Set 26" in the ground.

From Which:

- A P. Pine, 10" in dia., bears N47°15'W, 20.3 ft., scribed: SE 1/16 S28 BT
- A P. Pine, 12" in dia., bears S24°30'W, 18.5 ft., scribed: SE 1/16 S28 BT

Nailed a brass washer stamped PLS 848 on blaze above BT scribe as taken this survey. Nailed Bearing Tree (54-3) signs above blaze and Land Survey Monument (54-9) signs on back of each tree as required. Painted a 6" red band above Bearing Trees signs. Measurements to BT's taken with a magnetic compass, declination 20° East, and a nylon clad steel tape. Set steel fence post with Land Survey Monument (54-9) and Property Boundary (54-2) signs 5' north and 5' east of the monument.

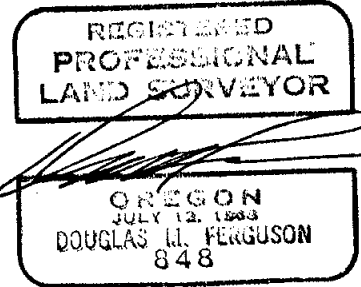

This work is performed by:
Douglas M. Ferguson PLS 848
Witnessed by:
D.Mitchell Ferguson & Rick Saul
April 1, 1991
Refer to Baker Co. Survey No. 9-37-181

Office of _____ County of _____
 State of _____ I hereby certify that the within instrument was filed
 in this office for record on the _____ day of _____, 19____ FILED 1-22-92
 _____ by _____
 (COUNTY OFFICIAL) (DEPUTY) BAKER COUNTY SURVEYOR
 SURVEY NO. 9-37-194