


CERTIFIED RECORD OF LAND CORNER MONUMENTATION

INDEX No. U-15

History of original corner establishment:

Corner established this survey.

DIAGRAM

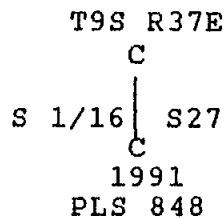

Description of corner evidence found:

Corner established this survey.


Description of monument and accessories I established to perpetuate the original location of this corner:

Set 2-1/2"x30" aluminum pipe with 3-1/2" aluminum cap, stamped as shown on the DIAGRAM, Set 27" in the ground.

From Which:

A P. Pine, 16" in dia., bears N89°00'W, 5.3 ft., scribed: C-S 1/16 S27 BT
A P. Pine, 16" in dia., bears S56°30'E, 63.3 ft., scribed: C-S 1/16 S27 BT

Nailed a brass washer stamped PLS 848 on blaze above BT scribe as taken this survey. Nailed Bearing Tree (54-3) signs above blaze and Land Survey Monument (54-9) signs on back of each tree as required. Painted a 6" red band above Bearing Trees signs. Measurements to BT's taken with a magnetic compass, declination 20° East, and a nylon clad steel tape. Set steel fence post with Land Survey Monument (54-9) and Property Boundary (54-2) signs 5' south and 3' west of the monument.

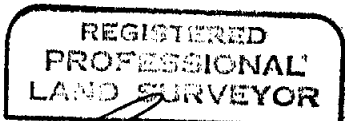

[Handwritten Signature]
D. M. FERGUSON
REGISTERED PROFESSIONAL LAND SURVEYOR

This work is performed by:
Douglas M. Ferguson PLS 848
Witnessed by:
D. Mitchell Ferguson & Rick Saul
April 2, 1991
Refer to Baker Co. Survey No. 9-37-181

Office of _____ County of _____
State of _____ I hereby certify that the within instrument was filed
in this office for record on the _____ day of _____, 19____ FILED _____/____-____-____

(COUNTY OFFICIAL) by _____ (DEPUTY) BAKER COUNTY SURVEYOR
SURVEY NO. 9-37-181