

CERTIFIED RECORD OF LAND CORNER MONUMENTATION

INDEX No. V-17

History of original corner establishment:

Corner was originally established in 1881 by Herman D. Gradon, under General Land Office Contract Number 416. Surveyor General's Notes state:

DIAGRAM

T9S R37E
S27|S26
S34|S35
1971
(BLM CAP)

Set a basalt stone 18x10x5 ins. 12 ins. in the ground for cor. to sec's 26, 27, 34 & 35, marked with 1 notch on S and 2 notches on E edges: from which

- A pine 24 ins. diam. bears N10°E, 94 lks. dist. marked T9S R37E S26 BT
A pine 36 ins. diam. bears S70°E, 113 lks. dist. marked T9S R37E S35 BT
A pine 48 ins. diam. bears S82°W, 132 lks. dist. marked T9S R37E S34 BT
A pine 24 ins. diam. bears N60°W, 110 lks. dist. marked T9S R37E S27 BT

In 1971 Owen C. Chatters II, Cadastral Surveyor for the BLM remonumented this corner under Special Instructions dated May 3, 1957, Group 350. BLM records states: The cor. of secs. 26, 27, 34 and 35, monumented with the original basalt stone 18x10x5 ins., firmly set 10 ins. in the ground, with illegible marks on S. and E. faces, from which the remains of the original bearing trees: A root hole, bears N10°E, 94 lks. dist. with a down pine alongside, 24 ins. diam., with scribe marks T9S R37E S26 BT visible on open blaze. A pine 36 ins. diam., bears S68°E, 115 lks. dist. with scribe marks T9S R37E S35 BT visible on open blaze. (Record, S70°E, 113 lks). A root hole, bears S82°W, 135 lks. dist., with a down pine alongside, 48 ins. diam., with scribe marks T9S R37E S34 BT visible on open blaze. (Record 132 lks.). A root hole, bears N60°W, 117 lks. dist., with a down pine alongside, 24 ins. diam., with scribe marks T9S R37E S27 BT visible on open blaze. (Record 113 lks.). At the corner point set an iron post, 28 ins. long, 2 1/2 ins. diam., 24 ins. in the ground with brass cap mkd. (SEE DIAGRAM) from which new bearing trees: A ponderosa pine, 10 ins. diam., bears N36°E., 51 lks. dist., mkd. T9S R37E S26 BT. A ponderosa pine, 10 ins. diam., bears S89°W, 16 lks dist., mkd. T9S R37E S34 BT. A ponderosa pine, 10 ins. diam., bears N56°W, 108 lks. dist., mkd. T9S R37E S27 BT. Deposit corner stone alongside iron post, and raise a mound of stone, 2 ft. base, 1 1/2 ft. high, W. of the corner.

Description of corner evidence found:

Found 2 1/2" iron post with a 3 1/2" brass cap stamped as shown in diagram. Monument is projecting 4 inches out of the ground. Monument is solid and in good condition.


- Ponderosa Pine, 12" dia, scribing visible, bears N57°33'W, 71.92 ft. Established by the BLM (Rec: N56°W, 71.28 ft)
Ponderosa Pine, 10" dia, dead and down with scribing visible, bears N33°51'E, 32.59 ft. Established by the BLM (Rec: N36°E., 33.66 ft)
Ponderosa Pine, 36" dia, snag with scribing visible, bears S68°09'E, 75.25 ft. Established by the original surveyor (Rec: S70°E, 74.58 ft.)
Ponderosa Pine, 12" dia, scribing visible, bears S88°28'W, 11.03 ft. Established by the BLM (Rec: S89°W, 10.56 ft.)

Measurements to existing BT's taken with an Electronic Tacheometer with bearings based on the survey control network.


Description of monument and accessories I established to perpetuate the original location of this corner:

No work is needed on the monument. From Which:

- A P. Pine, 14" in dia., bears N73°30'E, 28.6 ft., scribed: T9S R37E S26 BT
A P. Pine, 16" in dia., bears S48°45'E, 32.8 ft., scribed: T9S R37E S26 BT
Nailed a brass washer stamped PLS 848 on blaze above BT scribe as taken this survey. Nailed Bearing Tree (54-3) signs above blaze and Land Survey Monument (54-9) signs on back of each tree as required. Painted a 6" red band above Bearing Trees signs. Measurements to BT's taken with a magnetic compass, declination 20° East, and a nylon clad steel tape. Set steel fence post with Land Survey Monument (54-9) sign 5' north of the monument.

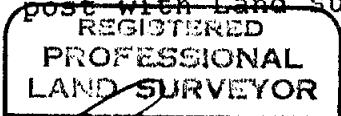

This work is performed by: Douglas M. Ferguson PLS 848
Witnessed by: D. Mitchell Ferguson & Rick Saul
April 1, 1991
Refer to Baker Co. Survey No. 9-37-181

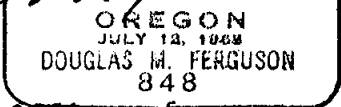

Office of _____ County of _____
State of _____ I hereby certify that the within instrument was filed
in this office for record on the _____ day of _____, 19____ FILED: 1-22-92
(COUNTY OFFICIAL) (DEPUTY) BAKER COUNTY SURVEYOR
SURVEY NO. 9-37-203