

CERTIFIED RECORD OF LAND CORNER MONUMENTATION

INDEX No. W-14

History of original corner establishment:

Corner was originally established by William L. Hanley, PLS 1639, in 1978, under Baker County Survey Number 9-37-20. His record states:

DIAGRAM

T9S R37E
NW 1/16
S34
1991
PLS 848

Set 5/8" x 30" rebar.

Description of corner evidence found:

Found 5/8"x30" rebar with plastic cap marked RPE 2808

No accessories set.

Description of monument and accessories I established to perpetuate the original location of this corner:

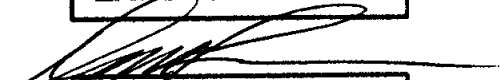
At the position of the above described 5/8" rebar:
Set 2-1/2"x30" aluminum pipe with 3-1/2" aluminum cap, stamped as shown on the **DIAGRAM**, Set 22" in the ground, over the rebar pin, and raised a mound of stone around the monument.

From Which:

A P. Pine, 12" in dia., bears N72°15'E, 9.3 ft., scribed: NW 1/16 S34 BT
A D. Fir, 14" in dia., bears N00°15'E, 42.7 ft., scribed: NW 1/16 S34 BT

Nailed a brass washer stamped PLS 848 on blaze above BT scribe as taken this survey. Nailed Bearing Tree (54-3) signs above blaze and Land Survey Monument (54-9) signs on back of each tree as required. Painted a 6" red band above Bearing Trees signs. Measurements to BT's taken with a magnetic compass, declination 20° East, and a nylon clad steel tape. Set steel fence post with Land Survey Monument (54-9) and Property Boundary (54-2) signs 5' north and 5' west of the monument.

REGISTERED
PROFESSIONAL
LAND SURVEYOR


OREGON
JULY 12, 1968
DOUGLAS M. FERGUSON
848

This work is performed by:
Douglas M. Ferguson PLS 848
Witnessed By:
D. Mitchell Ferguson & Rick Saul
April 2, 1991
Refer to Baker Co. Survey No. 9-37-181

Office of _____ County of _____
State of _____ I hereby certify that the within instrument was filed
in this office for record on the _____ day of _____, 19____ FILED _____ /-22-92

(COUNTY OFFICIAL) (DEPUTY) BAKER COUNTY SURVEYOR
SURVEY NO. 9-37-200