

History of original corner establishment:

Corner was originally established in 1881 by Eugene P. McCormack, under General Land Office Contract 398. Surveyor General's Notes state:

Set post 4 ft. long 4 ins. square, 24 ins. in the ground for cor. to secs. 3, 4, 33 and 34 marked
T9S S34 on NE
R37E S3 on SE
T10S S4 on SW and

DIAGRAM

T9S R37E
S33|S34
S 4|S 3
T10S
1971
(BLM CAP)

S33 on NW faces with 3 notches on E and W edges from which:

- A Pine 40 ins. diam. bears N85°E, 87 lks dist. marked T9S R37E S34 BT
- A Pine 30 ins. diam. bears S20°E, 102 lks dist. marked T10S R37E S3 BT
- A Pine 30 ins. diam. bears S25°W, 62 lks dist. marked T10S R37E S4 BT
- A Pine 40 ins. diam. bears N70°W, 75 lks dist. marked T9S R37E S33 BT

In 1971 Owen C. Chatters II, Cadastral Surveyor for the BLM remonumented this corner under Special Instructions dated May 3, 1957, Group 350. BLM records states: The cor. of secs. 3, 4, 33, and 34, monumented with an iron pipe, 30 ins. long, 1½ ins. diam., firmly set, projecting 4 ins. above ground, from which the remains of the original bearing trees: A root hole, bears N85°E., 87 lks. dist. A root hole, bears S20°E, 102 lks. dist. A pine stump, 30 ins. diam., bears S25°W., 62 lks. dist., with scribe marks BT visible on open blaze. At the corner point, set an iron post, 28 ins. long, 2¼ ins. diam., 24 ins. in the ground, with brass cap mkd. (SEE DIAGRAM) from which new bearing trees: A ponderosa pine, 14 ins. diam., bears N30°E, 57½ lks. dist., mkd. T9S R37E S34 BT. A ponderosa pine, 15 ins. diam., bears S42°E, 77 lks. dist., mkd. T10S R37E S3 BT. A ponderosa pine, 7 ins. diam., bears S72°W., 10 lks. dist., mkd. T10S R37E S4 BT. A ponderosa pine, 14 ins. diam., bears N72°W., 40 lks. dist., mkd. T9S R37E S33 BT. Deposit a granite stone, 11x8x6 ins., mkd X, and iron pipe alongside iron post, and raise a mount of stone, 2 ft. base, 1½ ft. high, W. of the corner.

Description of corner evidence found:

Found 2¼" iron post with a ¾" brass cap stamped as shown in diagram. Monument is projecting 4 inches out of the ground. Monument is solid and in good condition.

- Ponderosa Pine, 14" dia, dead and down with healed blaze, bears N73°38'W, 26.65 ft. Set by BLM (Rec: N72°W., 26.40 ft)
- Ponderosa Pine, 16" dia, healed blaze, bears N29°36'E, 38.15 ft. Set by BLM (Rec: N30°E, 37.95 ft)
- Ponderosa Pine, 18" dia, healed blaze, bears S43°47'E, 51.35 ft. Set by BLM (Rec: S42°E, 50.82)
- Ponderosa Pine, 8" dia, scribed X S4 BT, bears S62°36'W, 6.35 ft. Set by BLM (Rec: S72°W., 6.60 ft.)
- Ponderosa Pine stump, 28" dia, scribe S4 visible, bears S22°44'W, 41.58 ft. Set by orig. sur. (Rec: S25°W, 40.92')
- A metal pipe, 2" in dia., extending 12" out of the ground is 2 feet east of the monument.

Measurements to existing BT's taken with an Electronic Tacheometer with bearings based on the survey control network.


Description of monument and accessories I established to perpetuate the original location of this corner:

No work is needed on the monument.

From Which:

A Ponderosa Pine, 10" in dia, bears N82°45'W, 82.3 ft., scribed: T9S R37E S33 BT

Nailed a brass washer stamped PLS 848 on blaze above BT scribe as taken this survey. Nailed Bearing Tree (54-3) sign above blaze and Land Survey Monument (54-9) sign on back of tree as required. Painted a 6" red band above Bearing Trees sign. Measurements to BT taken with a magnetic compass, declination 20° East, and a nylon clad steel tape. Set steel fence post with Land Survey Monument (54-9) sign 5' north of the monument.

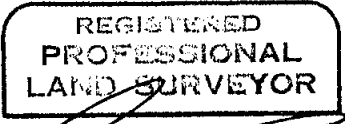

This work is performed by:
Douglas M. Ferguson PLS 848
Witnessed by:
D. Mitch Ferguson & Rick Saul
April 1, 1991
Refer to Baker Co. Survey No. 9-37-181

Office of _____ County of _____
State of _____ I hereby certify that the within instrument was filed
in this office for record on the _____ day of _____, 19____ FILED _____
by _____ (COUNTY OFFICIAL) _____ (DEPUTY) BAKER COUNTY SURVEYOR
SURVEY NO. 9-37-215