


CERTIFIED RECORD OF LAND CORNER MONUMENTATION

History of original corner establishment:

William E. Campbell, U.S. Deputy Surveyor
September 22, 1896

42.06 A tamarack, 15 ins. diam., on line, I mark with notches on N. and S. sides; descend;
hill bears N.20°W., and S.20°E., through dence undergroth.

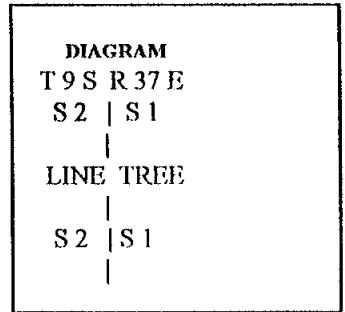

Description of corner evidence found:

Found a 12" diam. dead tree, 15-20' tall, visible notches on the north side, did not see any on south side as in the notes, the tree has fire damage.

Description of monument and accessories I established to perpetuate the original location of this corner:

- A tamarack 7" in diam., bears S.19°30'W., 55.7', double blazed and scribed "LT BT" with nail and washer "RLS 1060".
- A fir, 10" in diam., bears N.51°W., 35', double blazed and scribed "X BT" with nail and washer "RLS 1060"

Placed Forest Service signs (54-2,54-9) on trees and paint scars, blazes and a 6" red band around BT's.

REGISTERED PROFESSIONAL LAND SURVEYOR

R. David Schurian
7-15-96

OREGON JUNE 18, 1976 R. DAVID SCHURIAN 1060
--

Office of _____ County of _____
 State of _____ I hereby certify that the within instrument was filed in this office
 for record on the ___ day of _____, 19___
 _____ by _____
 (COUNTY OFFICIAL) (DEPUTY)

FILED 7-15-96
 BAKER COUNTY SURVEYOR
 SURVEY NO. 9-37-243