

CERTIFIED RECORD OF LAND CORNER MONUMENTATION


Z-19

History of original corner establishment:

Corner originally established in 1881 by Eugene P. McCormack under GLO Contract No. 398. Surveyor General records state: Set Post 3 ft long 3 ins square 24 ins in the ground for 1/4 sec cor marked 1/4 S on N face from which:

- A Pine 40 ins diam bears N55°W 1.06 lks dist marked 1/4 S BT
- A Pine 36 ins diam bears S35°W 88 lks dist marked 1/4 S BT

Note: The distance to the NW bearing tree was interpreted to be 1.06 chains.

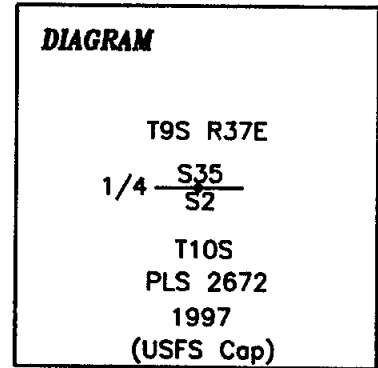

Description of corner evidence found:

Found no corner evidence. Searched a 200 foot radius around corner area on 3 separate occasions. Corner area has been both burned and logged. Re-establish corner position by single proportionate measurement based on the McCormack record.

Description of monument and accessories I established to perpetuate the original location of this corner:

Set 2 1/2" x 30" aluminum pipe with standard USFS 3 1/4" aluminum cap 24" in the ground surrounded by stone mound. Cap is stamped as shown in corner diagram. Set aluminum fenceposts with 54-9 and 54-2 signs 5' east and 5' west of corner monument.

New bearing trees established:

- 11" Ponderosa Pine bears S45°W 25.1' distance scribed 1/4 S2 BT.
- 10" Ponderosa Pine bears S48°E 42.6' distance scribed 1/4 S2 BT.
- 10" Ponderosa Pine bears N21°E 50.1' distance scribed 1/4 S35 BT.

New bearing object established:

Stone 2.3' W x 1.0' H x 1.6' D bears N86°W 20.1' distance marked B0 +.

New bearing trees have a brass washer stamped PLS 2672 nailed to face of blaze. Attached 54-3 and 54-9 signs to each bearing tree and painted face of blaze and a 6" band around each bearing tree. The distance is measured to a 50d nail in side center of bearing trees.

Compass declination 18° East.

Date: July 25, 1997

Witness: Roanna Ruston

FILED 7-27-97
 BAKER COUNTY SURVEYOR
 SURVEY NO. 2-37-254

REGISTERED
 PROFESSIONAL
 LAND SURVEYOR

Kenneth A. Lind

OREGON
 JULY 19, 1994
 KENNETH A. LIND
 2672

Renews 12/31/98

Office of.....County Surveyor..... County of.....Baker.....
 State of.....Oregon....., I hereby certify that the within was filed in this office
 for record on the..... day of....., 19.....
 by
 (COUNTY OFFICIAL) (DEPUTY)