

RECORD OF LAND CORNER MONUMENTATION

WITNESS POINT SITUATED IN T. 9 S., R. 37 E., W.M.

ORIGINALLY ESTABLISHED BY: Eugene P. McCornack, U.S. Deputy Surveyor

CONTRACT NUMBER: 398

CONTRACT DATE: July 2, 1881

SUBSEQUENT SURVEYS:

- ▶ Recovered by Charles M. Foster, U.S. Deputy Mineral Surveyor, on Mineral Survey No. 514, completed June 4, 1903
- ▶ G.L.O. Retracement by Lincoln E. Wilkes, U.S. Cadastral Engineer, under Group No. 107, Approved May 26, 1924
- ▶ Remonumented by William Hanley, PLS #1639, as evidenced by Certified Record of Land Corner Monumentation Record filed February 5, 1986, as Baker County Survey No. 8-37-88.

ORIGINAL DESCRIPTION: Set post 4 feet long 4 ins square 24 ins in the ground for cor to Secs 5, 6, 31 and 32 marked T8S S32 on NE; R37E S5 on SE; T9S S6 on SW and S31 on NW faces with 5 notches on E and 1 notch on W edges from which

A Pine 20 ins diam bears N35°E 41 lks dist marked T8S R37E S32 BT

A Pine 20 ins diam bears S10°W 120 lks dist marked T9S R36E S6 BT

A Tamarack 16 ins diam bears S10°E 86 lks dist marked T9S R37E S5 BT

A Pine 40 ins diam bears N50°W 13 lks dist marked T8S R37E S31 BT

FOSTER'S 1903 DESCRIPTION: From Corner 1 of Homestake Quartz Mining Claim, Foster's notes state: The corner to secs 5&6 T9S, R37E, Will. Me. on the Township line bears N65°54'W 484.9 ft. dist.

1924 G.L.O. DESCRIPTION: The cor., established for secs. 5, 6, 31, and 32, determined by reference to the bearing trees, bears south, 4.43 chs. dist. Hereafter, this cor. will serve as a witness point only. At exact cor. point, I set a fir post, 3 ft. long, 4 ins square, 24 ins. in the ground, marked W P on NE face. I destroy the marks on each of the bearing trees and remark each, W P BT.

HANLEY'S 1986 DESCRIPTION:

DESCRIPTION OF CORNER EVIDENCE FOUND:

A pine 48 ins diam bears N50°W, 13 lks dist with fragmentary scribes on partially healed blaze.

A pine snag 40 ins diam bears N35°E, 41 lks dist marked WP on pitched over blaze with typical healed blaze.

Rotten remains of tamarack windblow bears S10°E, 86 lks with typical blaze....no scribes on blaze remain.

Remains of sawed stump bears S10°W, 120 lks dist....no scribes or blaze remain.

DESCRIPTION OF MONUMENT AND ACCESSORIES I ESTABLISHED TO PERPETUATE THE ORIGINAL LOCATION OF THIS

CORNER: Set a 2 1/2"-inch aluminum cap on 2-inch diam aluminum pipe, 30 ins long and buried 25 ins in the ground with 5 ins projecting out of the ground with a surrounding rock mound and a 6-foot steel fence post alongside with a sign 54-9 attached. Aluminum cap marked as shown in corner diagram.


New bearing trees established: A fir 10 ins diam bears S47°W, 23.6 ft dist marked WPBT; A tamarack 15 ins diam bears S66°E, 19.6 ft dist marked WPBT

EVIDENCE FOUND: Found a 2 1/2" aluminum pipe with a 2 1/2" aluminum cap, marked as shown, in a 2 1/2 ft. diameter mound of stone, with a bent steel fence post with attached USFS sign 54-2 alongside.

From which, I found the following bearing trees:

- ▶ A ponderosa pine stump, bears N.35°E., 27 ft.
- ▶ A western larch, 15" dbh, bears S.66°E., 19.6 ft., with fully healed single blaze.
- ▶ A white fir, 15" dbh, bears S.47°W., 23.6 ft., with fully healed blaze.
- ▶ A ponderosa pine snag, 40"+ dbh, bears N.50°W., 8.6 ft. with visible scribing in partially healed blaze.

CORNER MONUMENT MARKED:

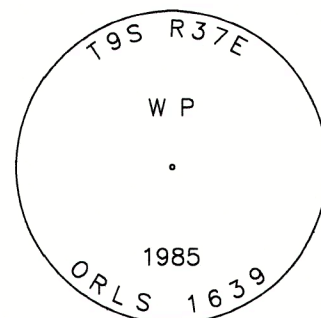

DESCRIPTION OF MONUMENTS AND ACCESSORIES SET AND METHODS USED:

I accept the position of the found monument for the corner. Straightened and reset the steel fence post with USFS sign 54-2. Painted a 6 inch red band around each bearing tree, painted the blazes red, and attached USFS 54-3 and 54-9 signs. Used a magnetic compass with 14° East declination to verify bearings to BT's. Used an EDM device to verify distances. See associated Map of Survey dated October 17, 2023 for survey-related information.

Work Performed September 26, 2023
Survey completed October 17, 2023

Jason L. Hatfield, PLS
Spencer B. Jones, Survey Tech
Ian R. Adler

USDA FOREST SERVICE
NORTHEAST OREGON LAND ZONE
1550 Dewey Avenue, Suite A
Baker City, OR 97814
(541) 523-1283

FILED December 20, 2023
BAKER COUNTY SURVEYOR
SURVEY NO. 9-37-341

REGISTERED
PROFESSIONAL
LAND SURVEYOR

OREGON
NOVEMBER 30, 2007
JASON L. HATFIELD
#69454

EXPIRES: 6/30/2025

A-5 W.P.