

**CERTIFIED RECORD OF LAND CORNER MONUMENTATION**

2 of 2

**Description of corner evidence found:**

A 2 inch aluminum pipe with a 2 1/2 inch aluminum cap, marked as shown. Firmly set 2 inches above ground, with rock collar.

From which:

A 26 inch fir snag (by Hagel) dead and down, with healed blaze, bears S58°E, 17.6 feet to stump hole.

A 22 inch white fir (by Hagel) with healed blaze, bears S81°E, 17.0 feet, alive & healthy.

A 17 inch fir snag (by Hagel) dead and down, with healed blaze, bears N79°E, 25.4 feet to stump hole.

A rotten fir stump (by Hagel), bears N54 1/2°E, 23.2 feet.

A 16 inch white fir (by Mitchell) with healed blaze, bears S49 1/2°W, 37.0 feet, alive & healthy.

A steel T-post falls South 3 feet with Land Survey Monument sign.

Monument falls West 1,500 feet from Fruit Creek Road; approximately 2,700 feet northerly of the intersection with NF-5540 Road.

**Description of monument and accessories I established to perpetuate original location of this corner:**

Added Bearing Tree and Land Survey Monument signs as needed.

NAD 83 Geodetic Position


Lat. 44°49'00.9" N  
Long. 118°12'56.3" W

Established by: Garmin ETREX 32x

I hereby certify that the corner is monumented and accessories taken as described using a steel tape and a Warren Knight staff compass, set with a declination of 14° East.


Witnesses: David Quittschreiber, Justin Seal

September 21, 2023

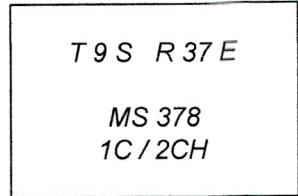

CHARLESTON  
Cor. 2

CENTURY  
Cor. 1

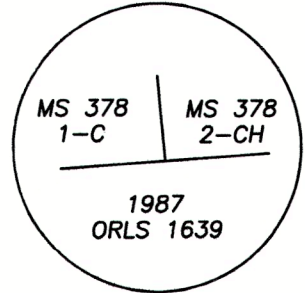

REGISTERED  
PROFESSIONAL  
LAND SURVEYOR

*Kristina Powell*

OREGON  
MAY 9, 2017  
**KRISTINA POWELL**  
91201

EXPIRES 12-31-24

FILED January 8, 2024  
BAKER COUNTY SURVEYOR  
SURVEY NO. 9-31-396