

PRIVATE LAND - WALKER
 W1/2 E1/2 NE1/4 SE1/4
 AND W1/2 NE1/4 SE1/4

(SEE 9-39-83 AND 9-39-200)
 FOUND 2" GALV. IRON PIPE
 WITH BRASS CAP ATTACHED
 MKD: T92 R39E

522
 C-E-E-E 1/256
 PLS 1206
 1985

66.00 R-O-W
 33.00 EACH
 SIDE OF ϕ

PRIVATE LAND - WALKER
 E1/2 SE1/4 NE1/4 NE1/4

(SEE 9-39-72)

66.00 R-O-W
 33.00 EACH
 SIDE OF ϕ

END R-O-W

555.03

SHEET

BEGIN R-O-W

S 00°11'05" E - 1317.54
 1046.08

NATIONAL FOREST LANDS
 E1/2 NE1/4 NE1/4 SE1/4


BUREAU OF LAND
 MANAGEMENT
 SW1/4 NW1/4

(SEE 9-39-84
 AND 9-39-200)

C-E-E-SE 1/256
 522
 SEE 9-39-97

LEGEND:
 SEE SHEET 6

LINE AND CURVE DATA:
 SEE SHEETS 4 & 5

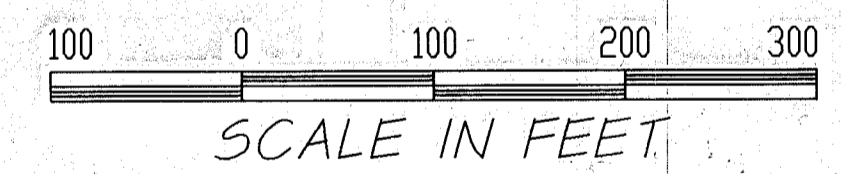

**5460 RIGHT-OF-WAY ACQUISITION
 USDA FOREST SERVICE
 PACIFIC NORTHWEST REGION
 WALLOWA-WHITMAN NATIONAL FOREST
 BAKER COUNTY, OREGON**

PROJECT NAME: WASHINGTON R-O-W

PROPERTY OWNER:
WALKER, TERRY L.

PROJECT LOCATION:
 SEC. 22-23, T. 9 S.,
 39 E., W.M.

FILED 3-27-95
 BAKER COUNTY SURVEYOR
 SURVEY NO. 9-39-260

REGISTERED
 PROFESSIONAL
 LAND SURVEYOR

 OREGON
 JULY 22, 1977
 GARY L. LANGLITZ
 1099
 EXPIRES: 12-31-2000
 2-20-95

SCALE: **1:100**
 DATE: **DEC., 1994-JAN., 1995**
 CONTRACT NO. **53-04M3-5-0004**

Anderson Perry Associates, Inc.
 ENGINEERING • SURVEYING • MATERIALS TESTING
 LA GRANDE, OR. WALLA WALLA, WA. LEWISTON, ID.

SHEET
2/7

9-39-260