


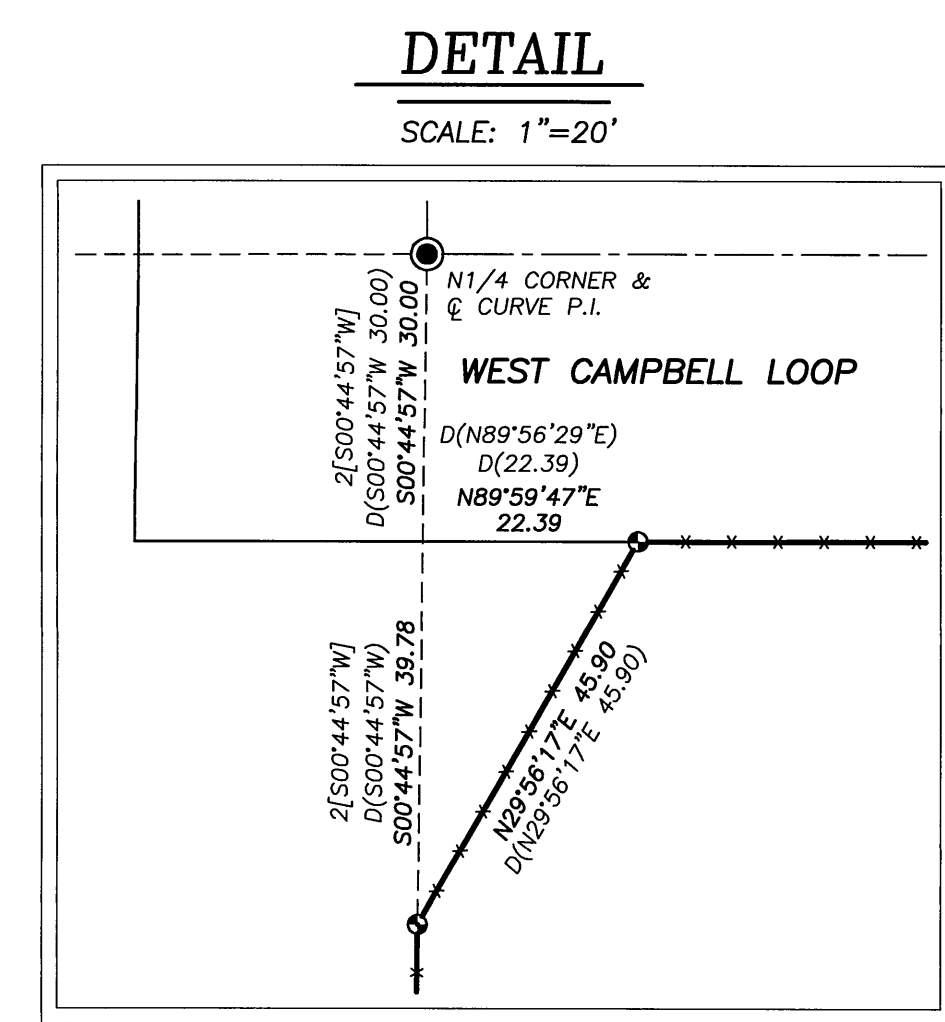

LEGEND

THE LOCATION OF THE NEW PROPERTY LINE WAS STAKED ON THE GROUND BY MR. VANDENBOS WHICH I MONUMENTED DURING THIS SURVEY. ALL OTHER NEW MONUMENTS WERE SET ACCORDING TO THE EVIDENCE FOUND AND THE PROCEDURES OUTLINED HEREIN.

- MAP OF SURVEY**
A PROPOSED PROPERTY LINE ADJUSTMENT
SITUATED IN THE NW1/4NE1/4 SECTION 13, T.9S., R.39E., W.M.,
BAKER COUNTY, OREGON

SURVEYED FOR	TODD AND LISA VANDENBOS		
SURVEYED BY	JLH	10/11/2019	
SCALE: 1"=100'	DRAWN BY: JLH		

FILED Oct. 15, 2019
BAKER COUNTY SURVEYOR
SURVEY NO. 9-39-309