


Bearings by Solar Obs.

VICINITY MAP
1"=2000

SEC. 1, T.9S., R.40E., W.M.

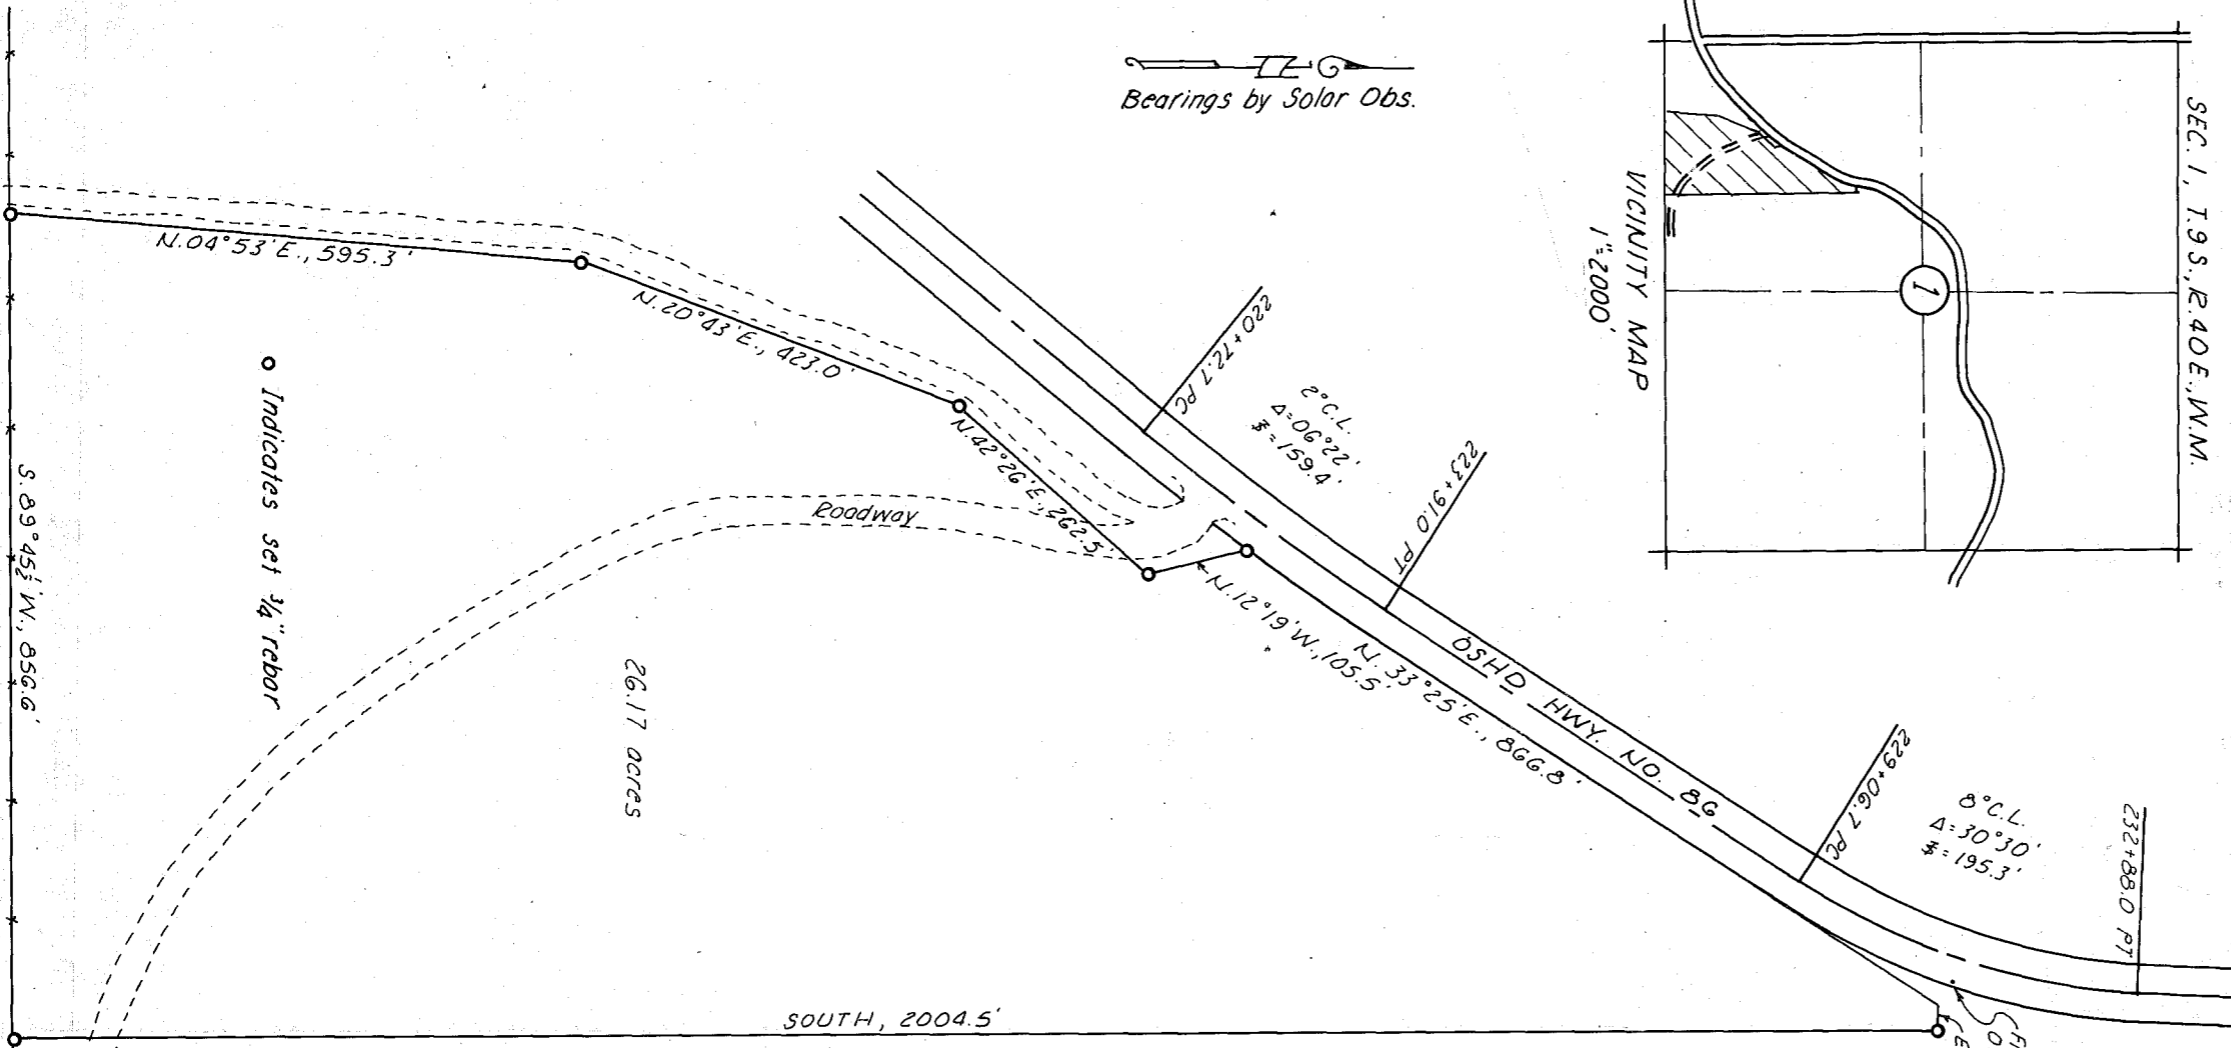

o Indicates set 1/4" rebar

26.17 acres

SOUTH, 2004.5'

S.89°45'W., 856.6'

N.89°59'W., 1017.2'

Fnd, marked stone for
South 1/4 cor. Sec. 1,
T.9S., R.40E., W.M.

Fnd, brass disc in conc. for
OSHD PI
EAST, 24.3'

TRACT SURVEY
Scale 1"=200' May 21, 1966
For Kermit Myers



FILED May 30, 1966
BAKER COUNTY SURVEYOR
SURVEY NO. 9-40-6B