

Found, city mon. CHERRY and WASHINGTON

Found, city mon. BALM and VALLEY

Fnd., city mon.

Fnd., city mon.

CHESTNUT ST.

CHERRY ST.

BALM ST.

PLUM ST.

(25)	(100)	10	(100)	11	(25)
		9		12	"
		8		13	"
		7		14	"
		6		15	"
		5		16	"
		4		17	"
		3		18	"
		2		19	"
(25)	(100)	1	(100)	20	(25)

BALM & PLACE ST. centerline located by projecting the tangent bet. mans. on AUBURN and VALLEY, the platted dist. of 310.0 feet. This point agrees with city reference data of original cor. location.

CHERRY and PLACE centerline is the intersection of tangents for CHERRY and WASHINGTON with CHESTNUT and PLACE through the relocated BALM and PLACE STS. centerlines.

FILED August 19, 1970
 BAKER COUNTY SURVEYOR
 SURVEY NO. 9-40-24A
 LOTS 16 THRU 20 and
 SOUTH 20 FT. OF LOT 15
 Set 1/2 inch rebars all cors.

Fnd., city mon.

Set nail, mon. not fnd

Set nail, mon. not fnd.


42

PACIFIC ADDITION

41

40

ESTES ST.

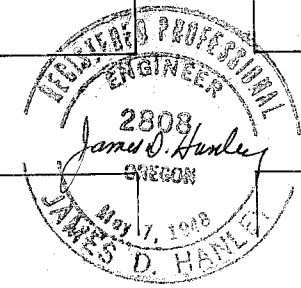

MAP OF SURVEY
 for
 Thomas. B. Haynes

August 19, 1970 Scale 1" = 100'
 24-A