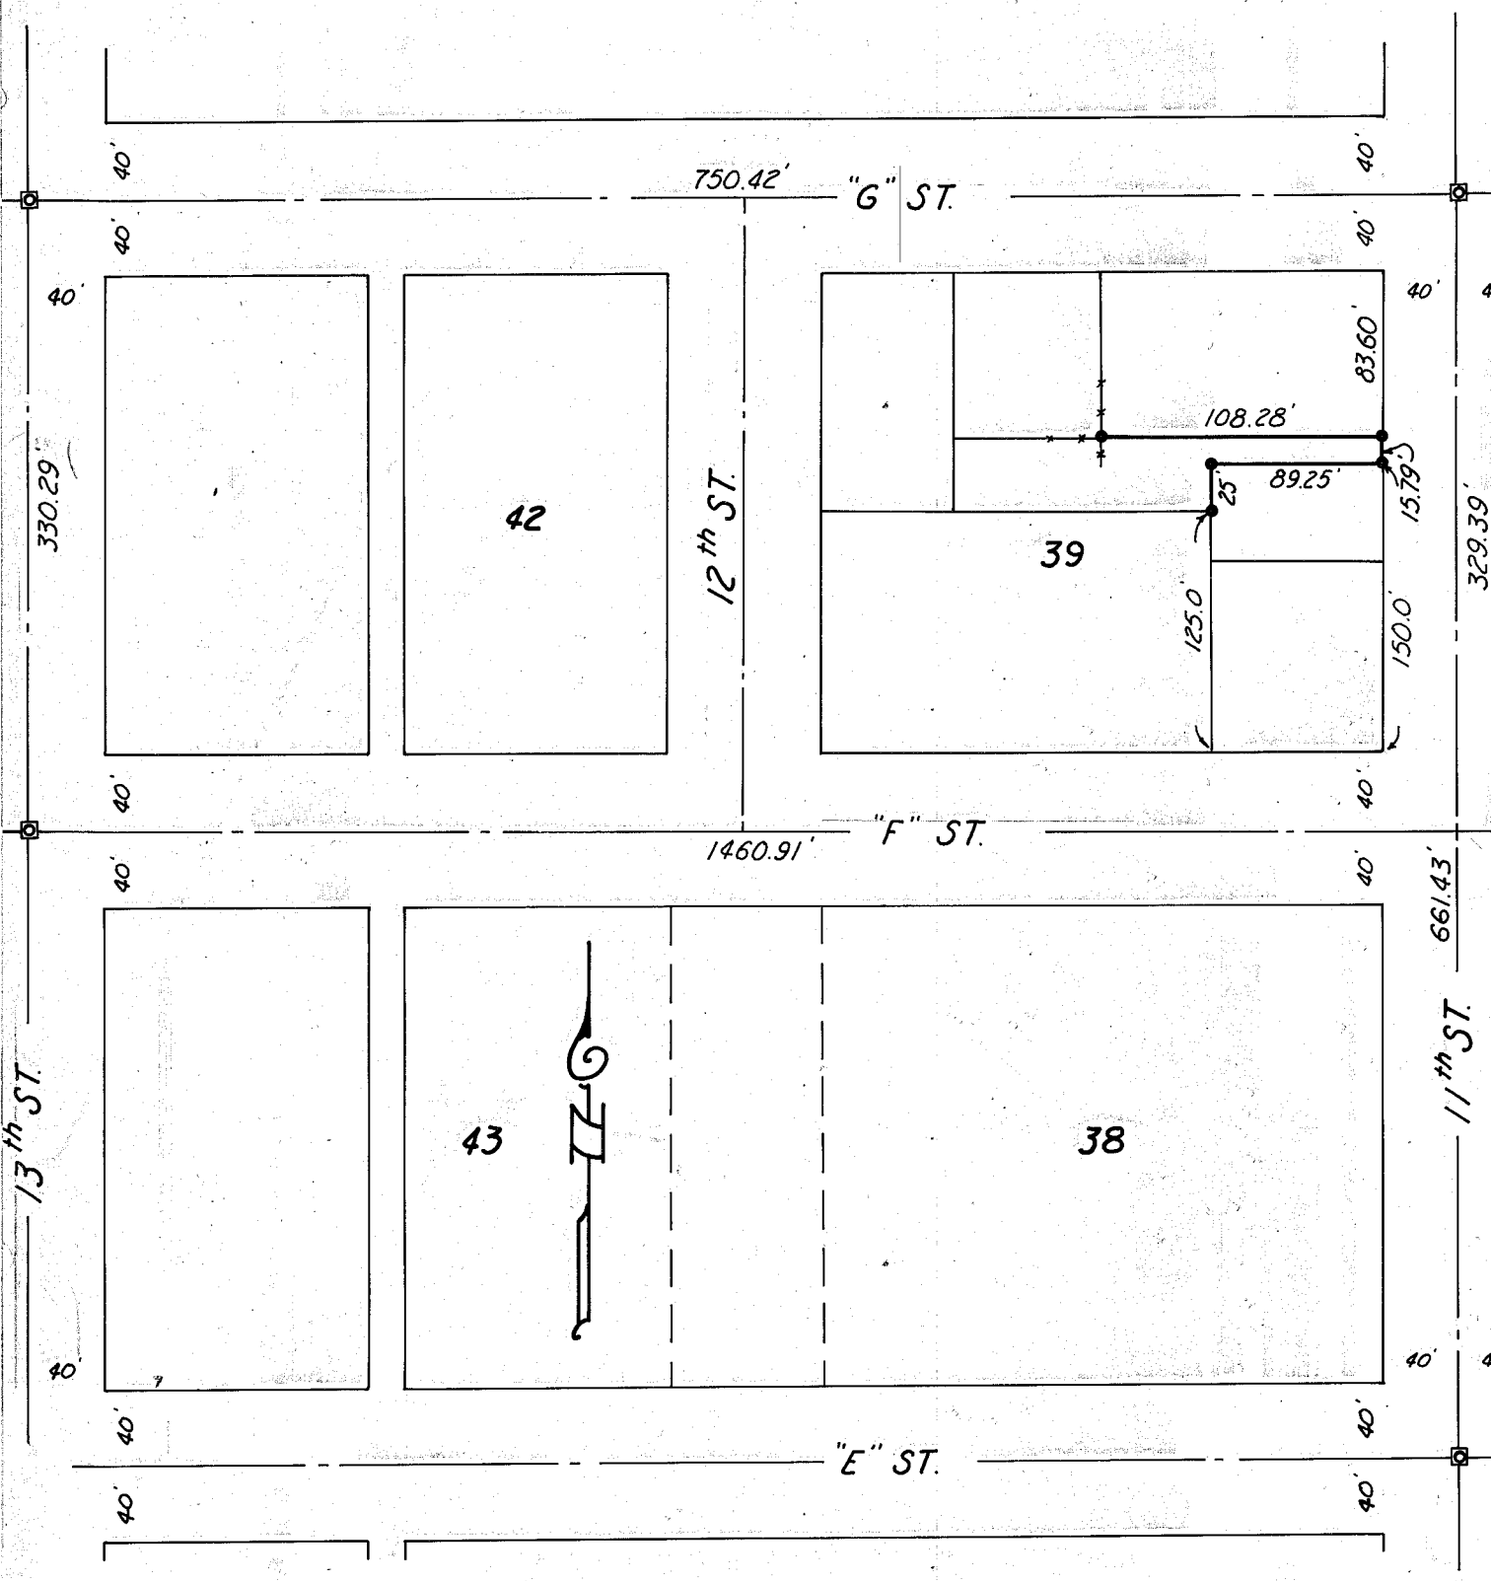

LEGEND

- ● Indicates set ½" rebar
- ○ " found mon. in box

MAP OF SURVEY
IN BLOCK 39, B.W. LEVENS ADDITION TO BAKER, OREGON

Surveyed June 5 & 7, 1973 Scale 1" = 100'

For Mrs. Ray Medlin

REGISTERED PROFESSIONAL ENGINEER
2808
James D. Hanley
OREGON
MAY 7, 1948
JAMES D. HANLEY

FILED June 19, 1973
BAKER COUNTY SURVEYOR
SURVEY NO. 9-40-49 BC