

 Meridian is City of Baker Grid
 of 1970 Survey. Rotate 1°38'
 for OSHD grid - Drng. No. 68-6-15
 Baker-Homestead Hwy.

N
 fc. cor. accepted
 ¼ cor. location

LEGEND

- Indicates set 5/8" x 30" rebar
- " " " fnd. mon. of record

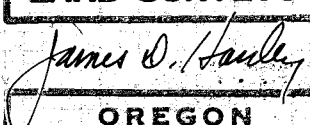
Remonumented ¼ cor. with
 2½" brass cap on 1" I.P.

Found the S¼ cor. stone for
 Sec. 1 & reestablished the sec.
 corner by intersecting county
 road (built on East line of
 Sec. 2) with line connecting
 SW cor. Sec. 2 and S¼ cor. Sec. 1.

MAP OF SURVEY
IN THE NW¼ SE¼ SECTION 2
T. 9 S., R. 40 E., W.M.

Surveyed Jan. 17 & 18, 1978 Scale 1"=660'
 For John Bootsma

FILED Jan. 18, 1978
 BAKER COUNTY SURVEYOR
 SURVEY NO. 9-40-30

REGISTERED
PROFESSIONAL
LAND SURVEYOR

OREGON
 SEPTEMBER 23, 1977
JAMES D. HANLEY
 1206