

**MAP**  
of  
**VICKIE SOUTH MAJOR PARTITION**  
PORTION of the NW<sup>4</sup> of Section 34, T9S, R40E WM.  
BAKER COUNTY OREGON  
Scale 1" = 100'

NOTE:

I, JAMES H. Hambleton do hereby certify that this is a true and exact copy of the original, as is recorded in the book for Major Partitions in the County Court House. This copy and accompanying narrative, is filed in the County Surveyors Office after plat was approved by the County Court and being a RECORD of SURVEY.

*James H. Hambleton*  
3-20-80

We the undersigned officers in and for Baker County, Oregon do hereby approve the map of

"VICKIE SOUTH MAJOR PARTITION"

*James D. Hanley* (SEE NOTE)  
County Surveyor

*Wm. W. Quigg* 3/31/80  
County Planning Director



County Commissioner

**LEGEND:**

- ⊙ Found Original GLO corner.
- ⊙ Iron Pin of unknown origin being called 1/4 corner.
- ⊙ Restored Section Corner using GLO field notes.
- ⊙ Initial Point
- 5/8" Iron Pin set during previous survey
- 5/8" Iron Pin set this survey.
- ( ) GLO Bearings & Distances.


Used Oregon State Highway 70 to find a iron pin of unknown origin located in a fence corner, and being called 1/4 corner.

Found GLO Stone 20'-12" x 12" in mound Stone.

Found GLO Stone 20'-12" x 12" in mound Stone.

Found GLO Stone 20'-12" x 12" in mound Stone.

Found GLO Stone 20'-12" x 12" in mound Stone.

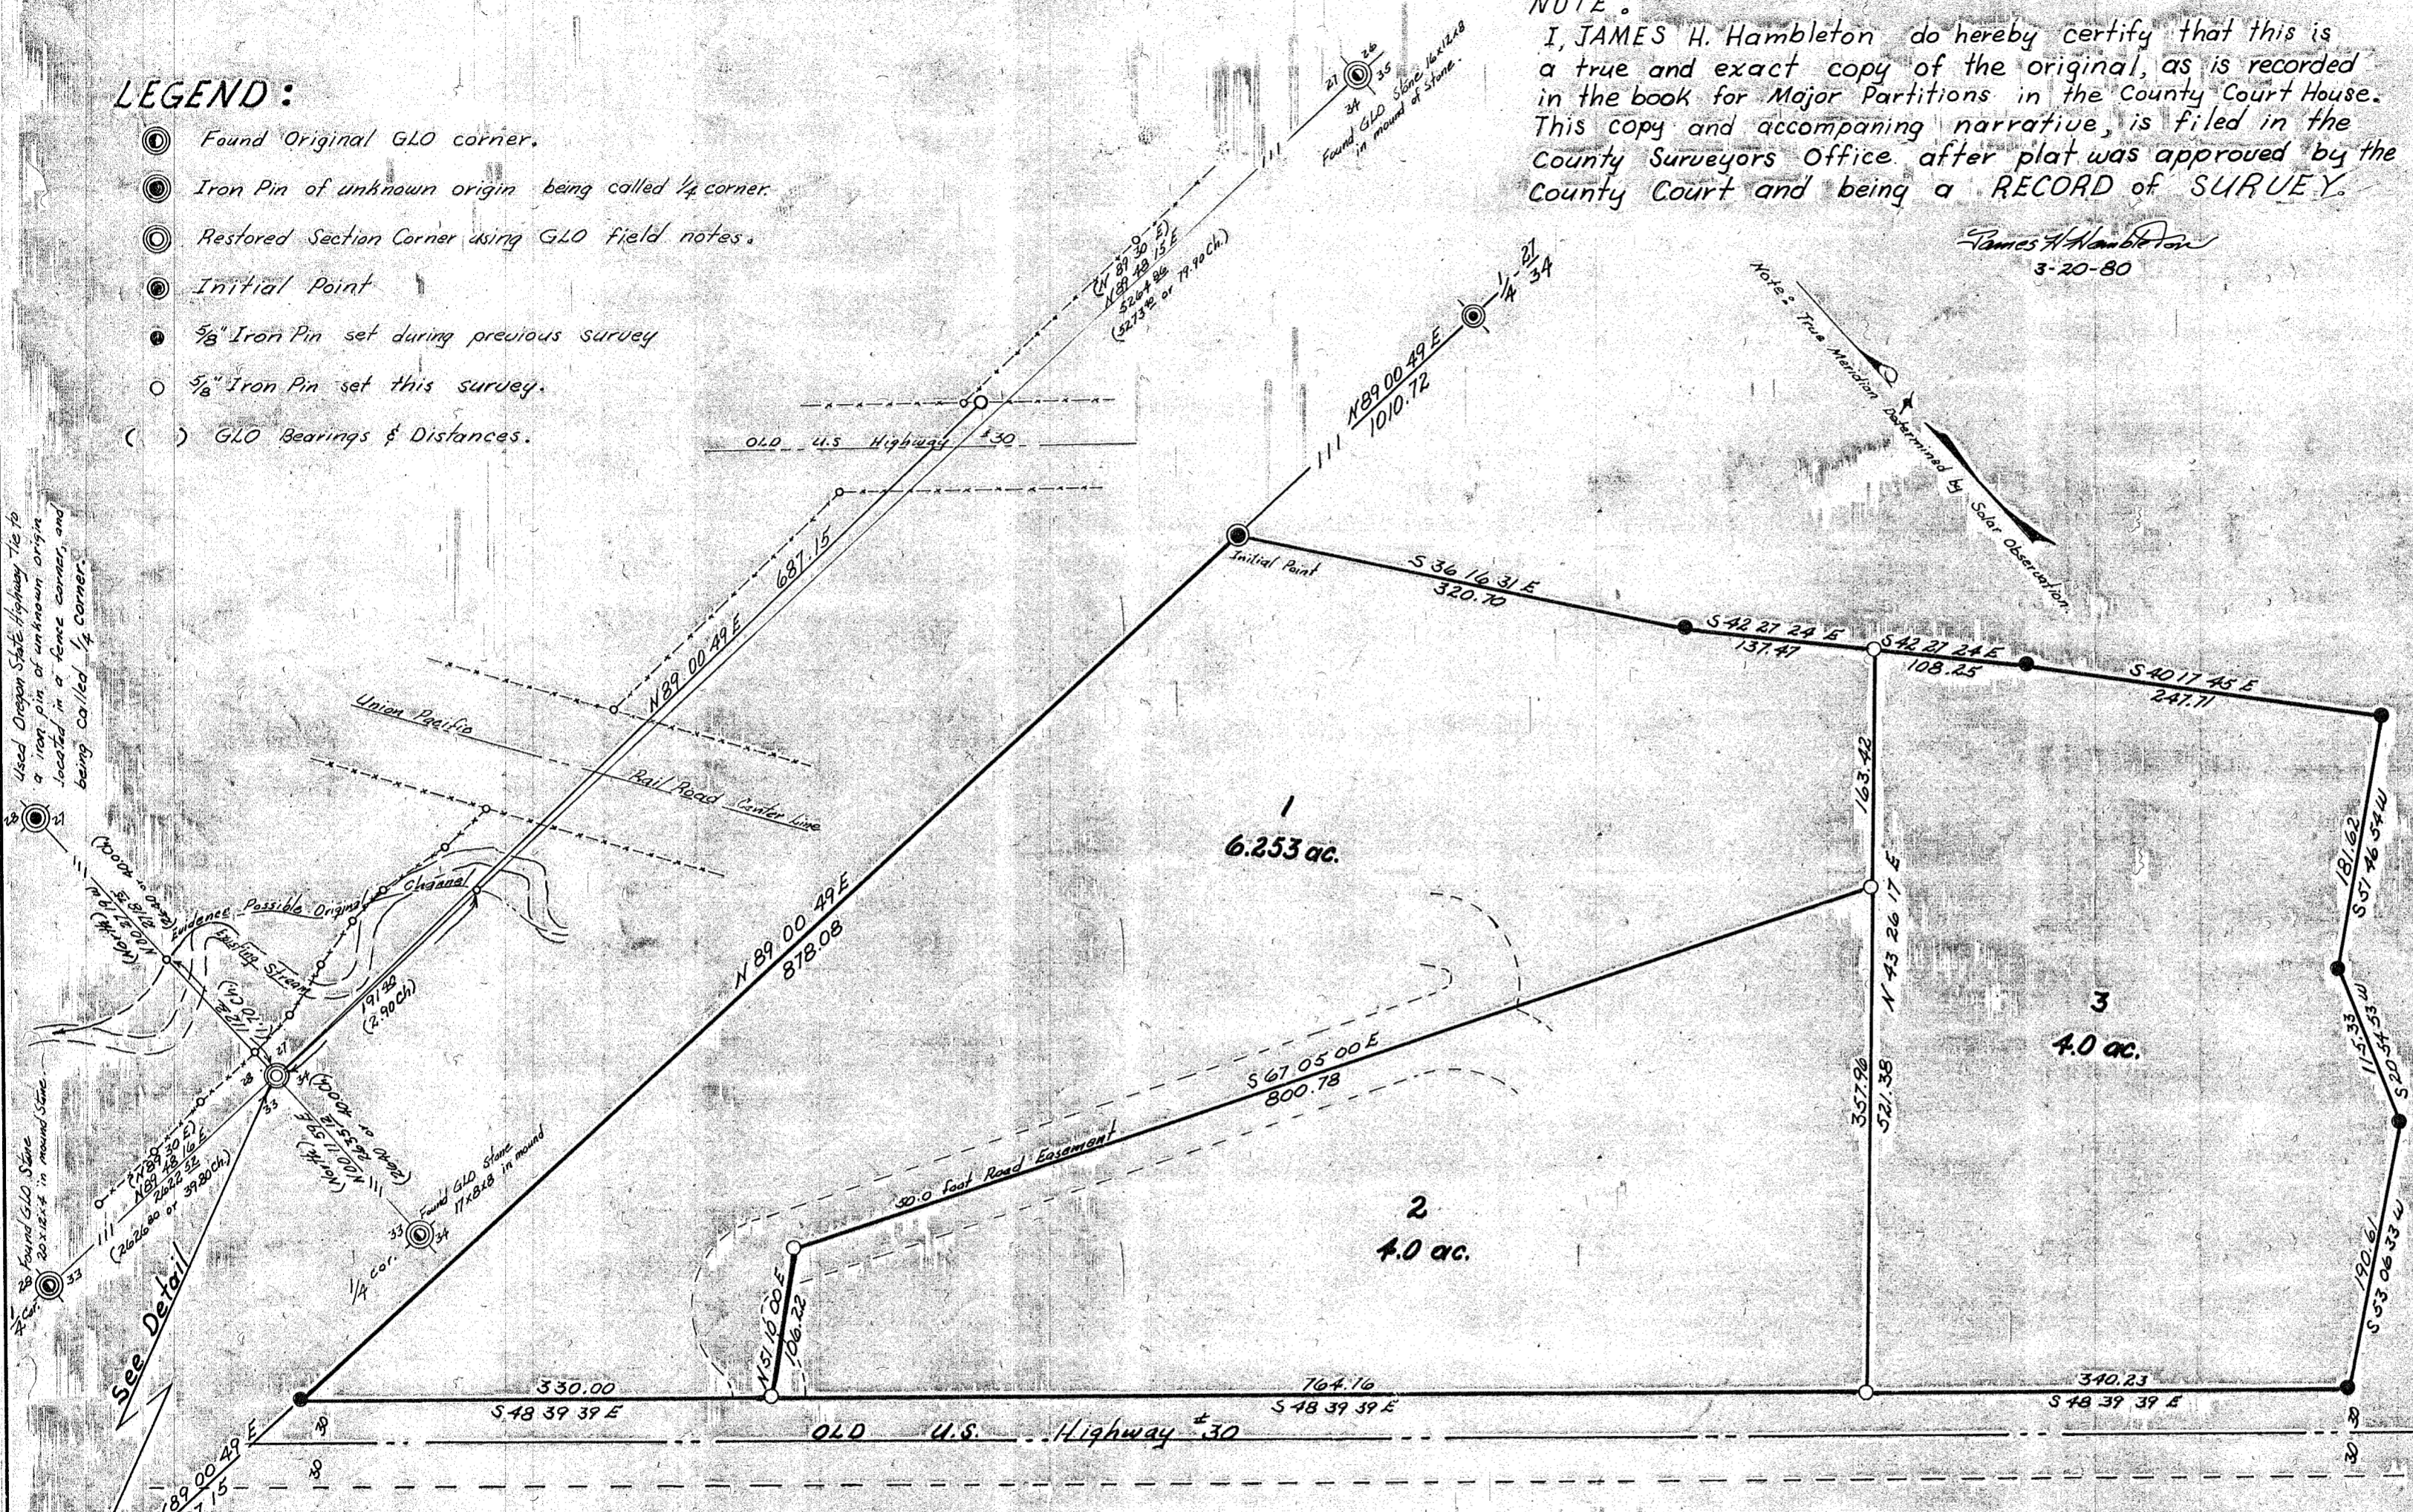

NOTE: COUNTY SURVEYOR APPROVAL OF THIS MAP DOES NOT NECESSARILY IMPLY CONCURRENCE WITH RE-LOCATION POSITION OF THE CORNER COMMON TO SECS. 27, 28, 33 and 34.

**OWNER:**  
**SUNBURST INC.**  
3165-10th St.  
Baker Oregon 97814  
Phone 523-6411

**SUBDIVIDER:**  
**RON DAUIS**  
3165-10th St.  
Baker Oregon 97814  
Phone 523-6411

**SURVEYOR:**  
**JAMES H. HAMBLETON**  
Rt 1 Box 20 A  
BAKER OREGON 97814  
Phone 523-3388

**CERTIFICATE OF SURVEY:**  
I, James H. Hambleton, being a registered Land Surveyor in the State of Oregon, do hereby certify that this map correctly represents a survey made by me or under my direction for Sunburst Inc., for the purpose of partitioning land for resale. Survey was performed using public and private records and in conformance with the BLM manual and the laws of the State of Oregon.

*James H. Hambleton*  
ORLS #415

REGISTERED PROFESSIONAL LAND SURVEYOR

*James H. Hambleton*

OREGON  
JULY 20, 1980  
JAMES H. HAMBLETON  
695

FILED March 20, 1980  
BAKER COUNTY SURVEYOR  
SURVEY NO. 40-37