


CERTIFIED RECORD OF LAND CORNER MONUMENTATION

History of original corner establishment:

Corner established by Thompson and Chaplin under GLO contract no. 104 dated April 16, 1864.

Surveyor General records state:

Set stone 36 x 8 x 8 ins for cor to secs 23, 24, 25 and 26.

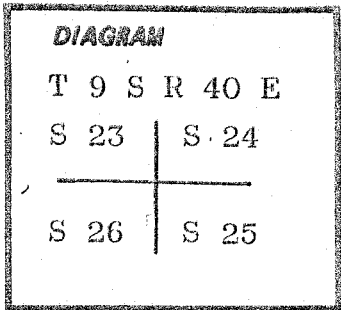

Description of corner evidence found:

Found an ancient fence corner from which the fence lines run north and west.


Description of monument and accessories established to perpetuate the original location of this corner:

Set a 2½ inch brass cap on a 1 inch iron pipe 31 inches long and projecting 4 inches out of the ground with a surrounding rock mound.

Brass cap marked thus:

T 9 S R 40 E
S 23 S 24
S 26 S 25
CS 1981

I hereby certify that the above described corner monument was properly established on March 25, 1981, under my supervision and witnessed by Brad Gordon, Tom Fisk and Jim DeMastus.

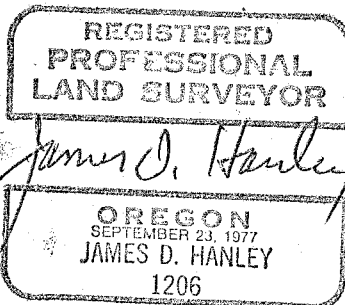

Office of..... County of.....
 State of....., I hereby certify that the within instrument was filed in this office
 for record on the..... day of....., 19.....
 by
 (COUNTY OFFICIAL) (DEPUTY)