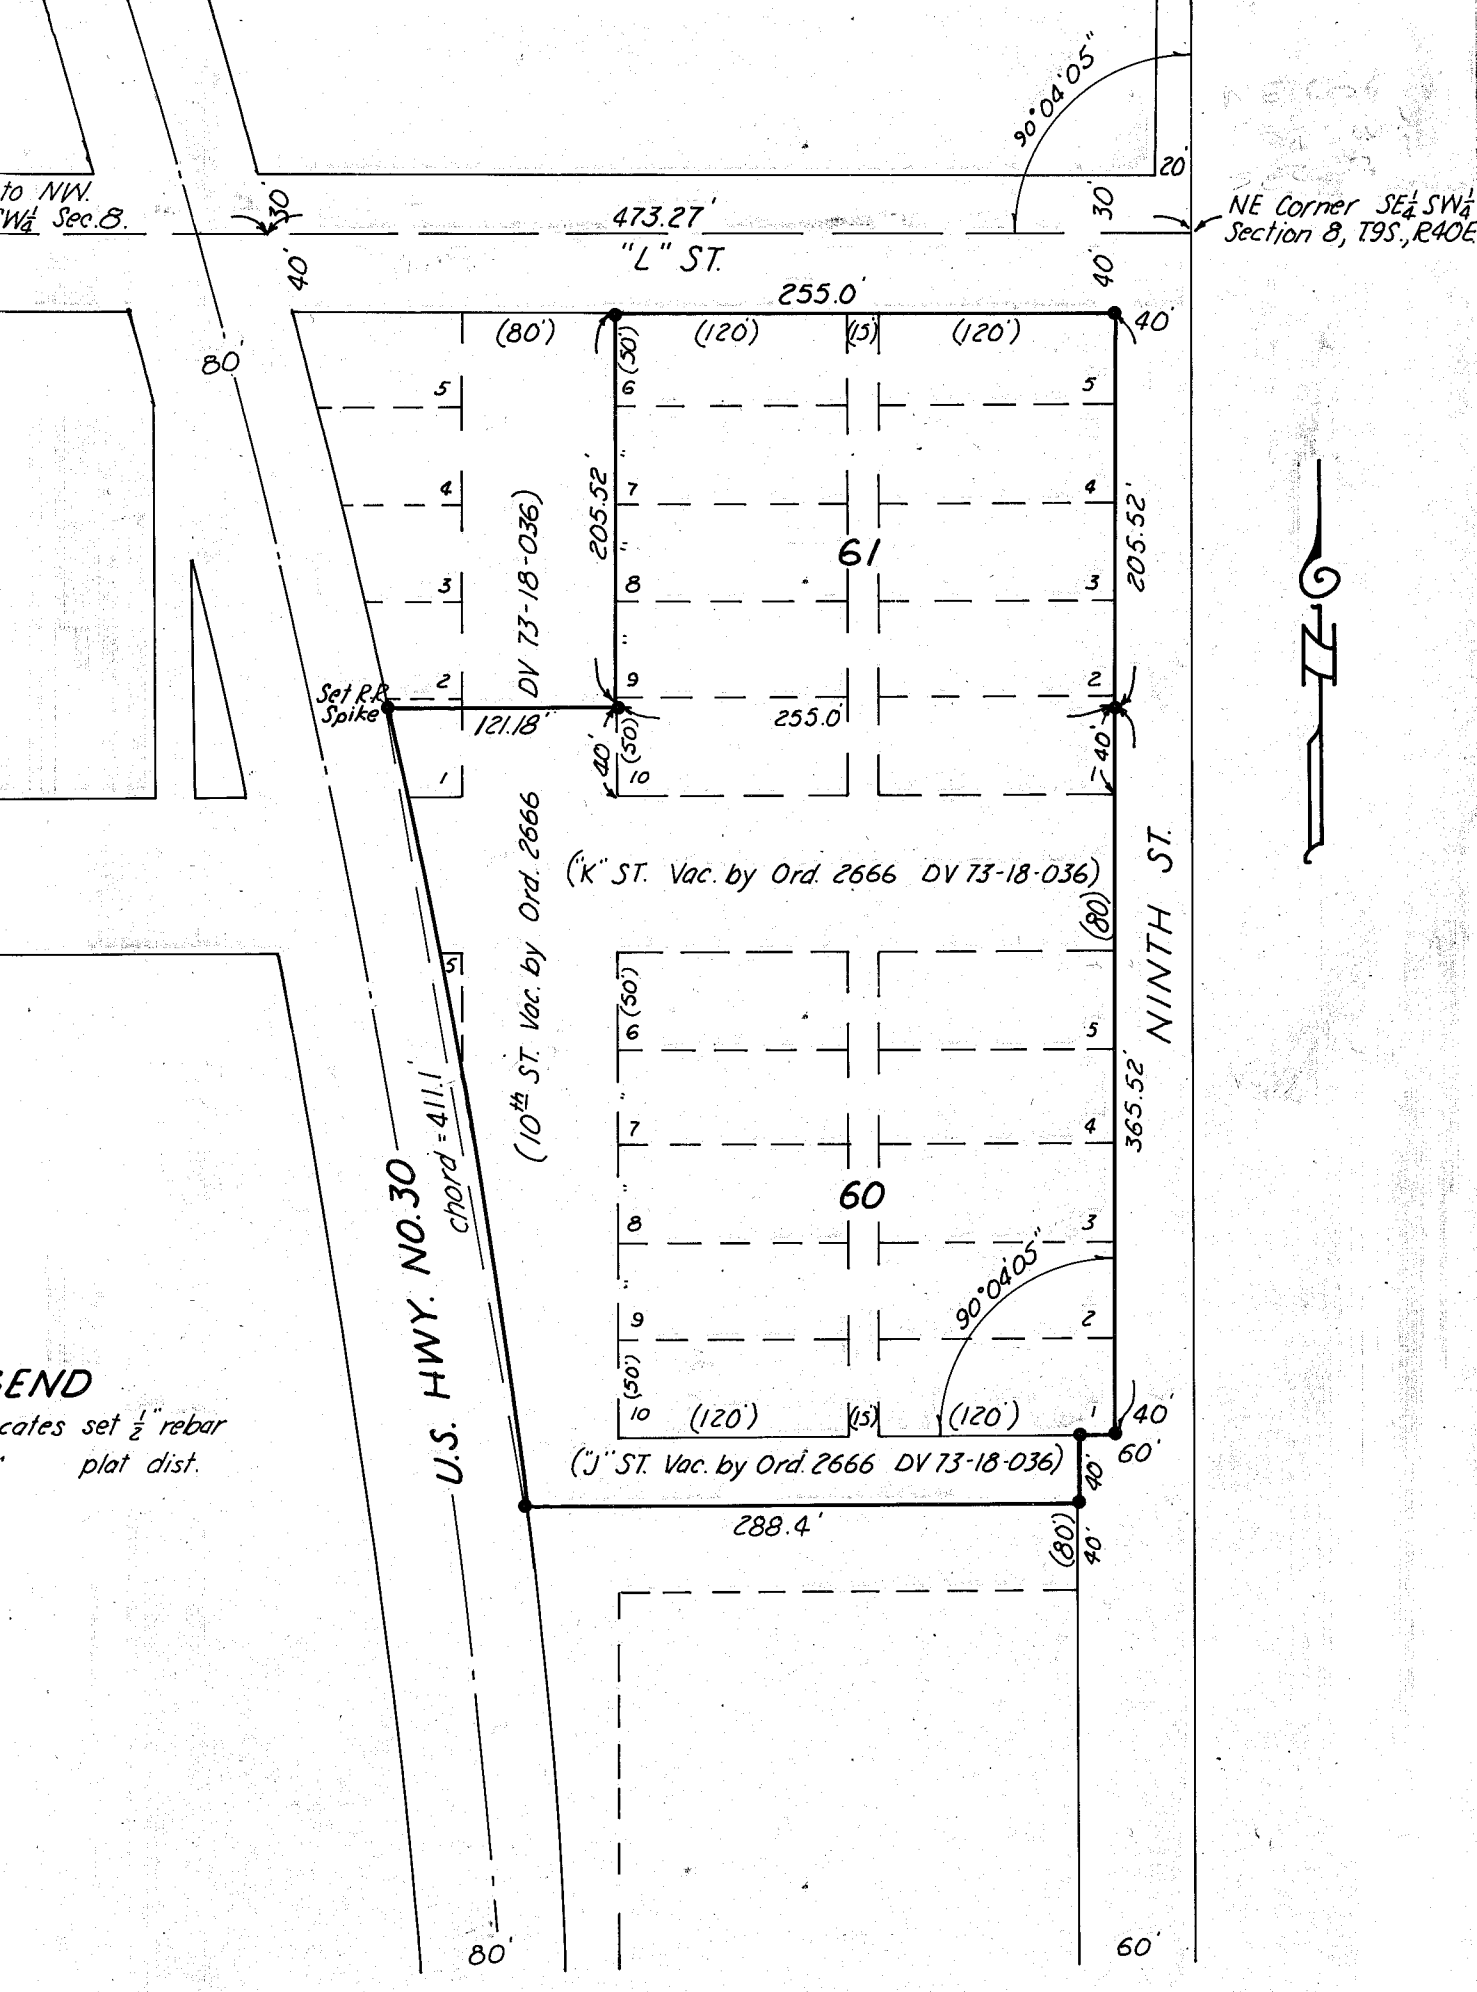

END

cates set ½" rebar

plat dist.

MAP OF SURVEY

BLOCKS 60 & 61, AND A PORTION OF BLOCK 62 & 63 B.W. LEVENS ADD'N. TO BAKER, ORE.

Surveyed Nov. 2 & 6, 1973 Scale 1" = 100'

For Dole Lethlean

D Nov. 10, 1973

ER COUNTY SURVEYOR

VEY NO. 9-40-50 BC

REGISTERED PROFESSIONAL ENGINEER 2808 James D. Hanley OREGON JAMES D. HANLEY