


CERTIFIED RECORD OF LAND CORNER MONUMENTATION

History of original corner establishment:

Corner established by Thompson and Chaplin under GLO contract no. 104 dated April 16, 1864.

Surveyor General records state:

Set post for 1/4 sec cor in mound of earth with charred stake, pits and trench as per instructions.

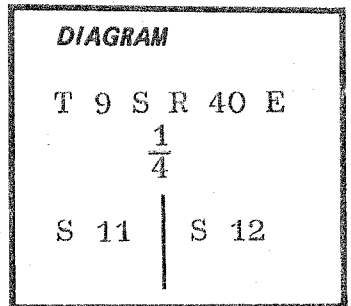

Description of corner evidence found:

Original corner post not found and corner position remonumented by single proportionate distance.

Description of monument and accessories I established to perpetuate the original location of this corner:


Set a 2½ inch brass cap on a 1 inch iron pipe 31 inches long and projecting 5 inches out of the ground.

Brass cap marked thus:

T 9	S R	40	E
	$\frac{1}{4}$		
S 11		S 12	
CS 1981			

I hereby certify that the above described corner monument was properly established on May 14, 1981, under my supervision and witnessed by Brad Gordon, Tom Fisk and Jim DeMastus.

FILED May 20, 1981  
 BAKER COUNTY SURVEYOR  
 SURVEY NO. 9-40-52

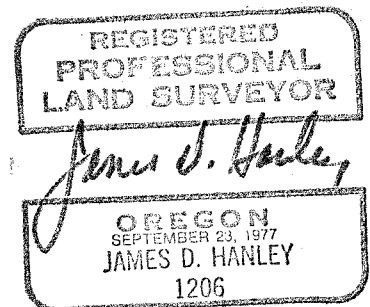

Office of..... County of.....  
 State of....., I hereby certify that the within instrument was filed in this office  
 for record on the..... day of....., 19.....  
 ..... by .....  
 (COUNTY OFFICIAL) (DEPUTY)