


CERTIFIED RECORD OF LAND CORNER MONUMENTATION

History of original corner establishment:

Corner established by Thompson and Chaplin under GLO contract no. 104 dated April 16, 1864.

Surveyor General record states:

Set post in mound of earth, with charred stake, pits and trench as per instructions.

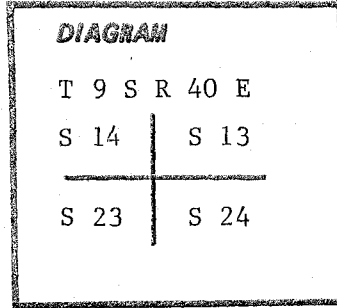

Description of corner evidence found:


None, corner is reestablished by double proportionate measurement from the adjacent quarter section corners.

Reference: Survey No. 9-40-54

Description of monument and accessories established to perpetuate the original location of this corner:

Set a 2½ inch brass cap on a 1 inch iron pipe 31 inches long and projecting 7 inches out of the ground with a surrounding rock mound.

Brass cap marked thus:

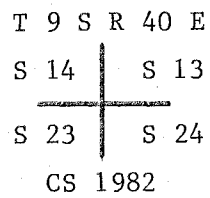

No new accessories established for this corner monument.

I hereby certify that the above described corner monument was properly established under my supervision on February 26, 1982, and witnessed by Tom Fisk and Jim DeMastus.

REGISTERED
PROFESSIONAL
LAND SURVEYOR

James D. Hanley
OREGON
SEPTEMBER 23, 1977
JAMES D. HANLEY
1206

Office of..... County of.....

State of....., I hereby certify that the within instrument was filed in this office for record on the..... day of....., 19.....

..... by

(COUNTY OFFICIAL)

(DEPUTY)

Form R6-7100-51 (9/71)

FILED APRIL 9 1982
BAKER COUNTY SURVEYOR
SURVEY NO. 9-40-59

☆ GPO—798-276