


CERTIFIED RECORD OF LAND CORNER MONUMENTATION

History of original corner establishment:

Corner established by Thompson and Chaplin under GLO contract no. 104 dated April 16, 1864.

Surveyor General record states:

Sec stone 30"x18"x4" for 1/4 Sec corner.

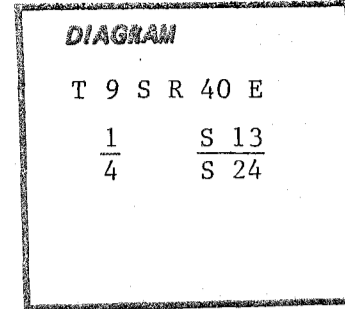

Description of corner evidence found:

Found a stone 30"x21"x6" marked with 1/4 on North side.

Reference: Survey No. 9-40-54

Description of monument and accessories established to perpetuate the original location of this corner:

Set a 2½ inch brass cap on a 1 inch iron pipe 31 inches long and projecting 8 inches out of the ground with a surrounding rock mound. Buried original stone 1 foot North of brass cap monument.

Brass cap marked thus: T 9 S R 40 E

	$\frac{1}{4}$	S	13
		S	24

CS 1982

No new accessories established to this corner monument.

I hereby certify that the above described corner monument was properly established under my supervision on February 26, 1982, and witnessed by Tom Fisk and Jim DeMastus.



Office of..... County of.....
 State of....., I hereby certify that the within instrument was filed in this office
 for record on the..... day of....., 19.....
 by
 (COUNTY OFFICIAL) (DEPUTY)