


CERTIFIED RECORD OF LAND CORNER MONUMENTATION

**History of original corner establishment:**

Corner established by Thompson and Chaplin under GLO contract no. 104 dated April 16, 1864.

**Surveyor General record states:**

Set post in mound of earth with charred stake, pits, trench as per instructions

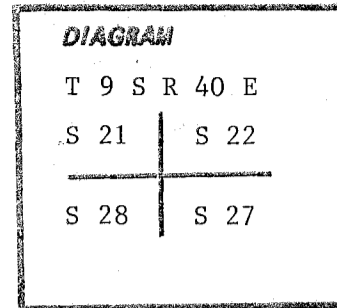

**Description of corner evidence found:**

None: The West quarter section corner common to Sections 27 and 28 is reconstructed from OSHD tie recorded on OSHD Drng No. 9B-1-26, Baker-Pleasant Valley Section. The Northwest corner to Section 27 is reconstructed according to the Robert Leep, Registered Professional Engineer, map of 1935, wherein he tied to the fence corner marking the said quarter section corner common to Sections 27 and 28 (Leep station 26+83.7 from the Southwest corner of Section 27), the fence corner at station 40+02.3 (now monumented with a 3/4 inch pipe), and the Northwest corner to Section 27 (Leep station 53+56.0). The found 3/4 inch iron pipe bears N 01°51'05" W, 1335.82 feet from the said corner common to Sections 27 and 28. No documentation is available for the origin or source of this iron pipe, but evidence exists that it lies in an old North-South fence line, and believed to be that fence shown on the Leep map. A projection along this found bearing at the Leep distance of 2672.3 feet from the said corner common to Sections 27 and 28 is the most likely position of the original section corner location. (Note that this distance of 2672.3 compares with 1335.83 feet from OSHD quarter section corner tie to the found iron pipe which was probably set at mid-point for 1/16 cor).

**Description of monument and accessories established to perpetuate the original location of this corner:**

Set a 2½ inch brass cap on a 1 inch iron pipe 31 inches long and projection 6 inches out of the ground with a surrounding stone mound.


Brass cap marked thus:

T 9 S R 40 E	
S 21	S 22
—+—	
S 28	S 27

CS 1982

No accessories established to this corner monument. Reference: Survey No. 9-40-54

I hereby certify that the above described corner monument was properly established under my supervision on March 4, 1982, and witnessed by Brad Gordon and Jim DeMastus.

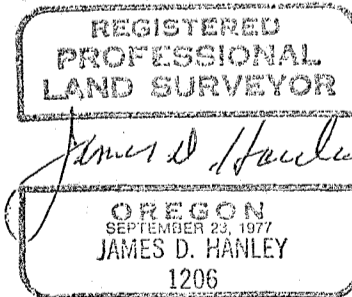

Office of..... County of.....  
 State of....., I hereby certify that the within instrument was filed in this office  
 for record on the..... day of....., 19.....  
 ..... by .....  
 (COUNTY OFFICIAL) (DEPUTY)

Form R6-7100-51 (9/71)

FILED April 9, 1982  
 BAKER COUNTY SURVEYOR  
 SURVEY NO. 9-40-61