


CERTIFIED RECORD OF LAND CORNER MONUMENTATION

History of original corner establishment:

Corner established by Thompson and Chaplin under GLO contract no. 104 dated April 16, 1864.

Surveyor General record states:

Set stone 16"x10"x6" for 1/4 Sec corner

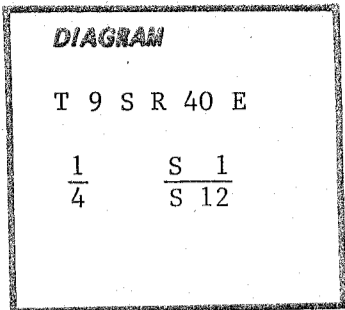

Description of corner evidence found:

Found a stone 17"x11"x6" marked 1/4 on North face in a East-West running fence line.

Description of monument and accessories established to perpetuate the original location of this corner:

Set a 2½ inch brass cap on a 1 inch iron pipe 31 inches long and projecting 6 inches out of the ground and buried original stone 1 foot North of brass cap monument.

Brass cap marked thus:

T 9 S R 40 E

$\frac{1}{4}$	$\frac{S 1}{S 12}$
---------------	--------------------

CS 1982

No new accessories were established to this corner monument.

I hereby certify that the above described corner monument was properly established on March 4, 1982, under my supervision and witnessed by Brad Gordon and Jim DeMastus.

REGISTERED
PROFESSIONAL
LAND SURVEYOR

James D. Hanley

OREGON
SEPTEMBER 23, 1977
JAMES D. HANLEY
1206

Office of..... County of.....
 State of....., I hereby certify that the within instrument was filed in this office
 for record on the..... day of....., 19.....

..... by

(COUNTY OFFICIAL)

(DEPUTY)

Form R6-7100-5/ (9/71)

FILED APRIL 9, 1982
 BAKER COUNTY SURVEYOR
 SURVEY NO. 9-40-62