


NOTE
 Fnd Hwy R/W mon. 0.30'
 North of section line. Set
 rebar 20' from sec. line.
 (19.79' bet. mons.)

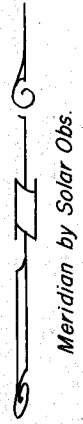


- LEGEND:
- Indicates Set 1/2" Rebar
 - Indicates Fnd. HWY R/W Mon.
 - ⊙ Indicates Fnd. 1/2" Rebar

MAP OF SURVEY

A PARCEL IN THE SE 1/4 SE 1/4 SEC. 9, T.9S., R.40E., W.M.

Surveyed May 29, 1975
 June 2, 1975

Scale 1"=100'

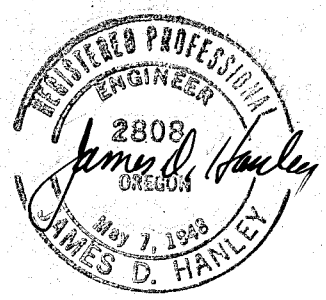

FILED June 30, 1975
 BAKER COUNTY SURVEYOR
 SURVEY NO. 9-40-64 B C

For Transcon Lines