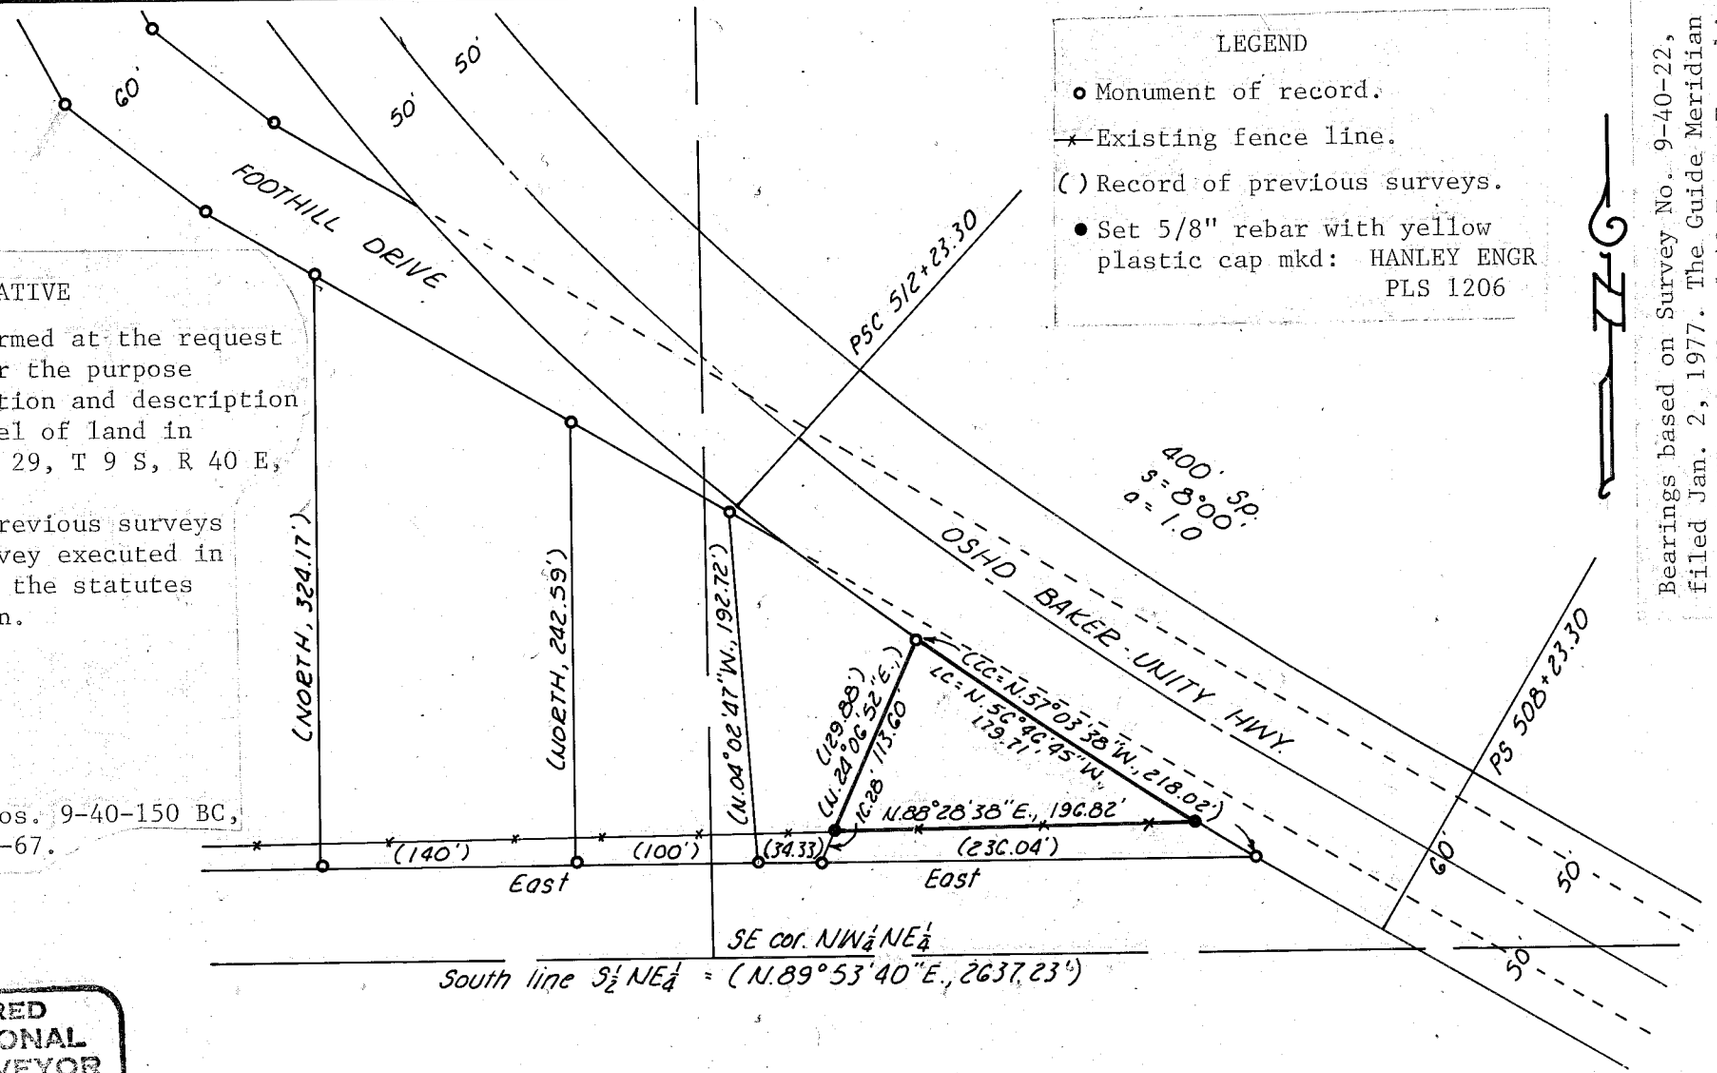

LEGEND

- o Monument of record.
- —x— Existing fence line.
- ( ) Record of previous surveys.
- ● Set 5/8" rebar with yellow plastic cap mkd: HANLEY ENGR PLS 1206

Bearings based on Survey No. 9-40-22, filed Jan. 2, 1977. The Guide Meridian between Ranges 39 and 40 East, Township 9 South bears NORTH, between the Southwest corner Sec. 31 and the Northwest corner Sec. 19.

SURVEY NARRATIVE

This survey was performed at the request of Francis DeRoest for the purpose of boundary monumentation and description preparation of a parcel of land in the NE¼NE¼ of Section 29, T 9 S, R 40 E, W.M.
Survey control from previous surveys was recovered and survey executed in full conformance with the statutes of the State of Oregon.

REFERENCE SURVEYS:

Baker County Survey Nos. 9-40-150 BC, 9-40-161 BC, and 9-40-67.

REGISTERED PROFESSIONAL LAND SURVEYOR

William L. Hanley

OREGON
JULY 14, 1978
WILLIAM L. HANLEY
1639

MAP OF SURVEY

IN THE NE¼NE¼, SECTION 29, T 9 S, R 40 E, W.M.

Surveyed Sept. 9, 1982 Scale 1"=100'

For Francis DeRoest

FILED Sept. 14, 1982

BAKER COUNTY SURVEYOR

SURVEY NO. 9-40-67A