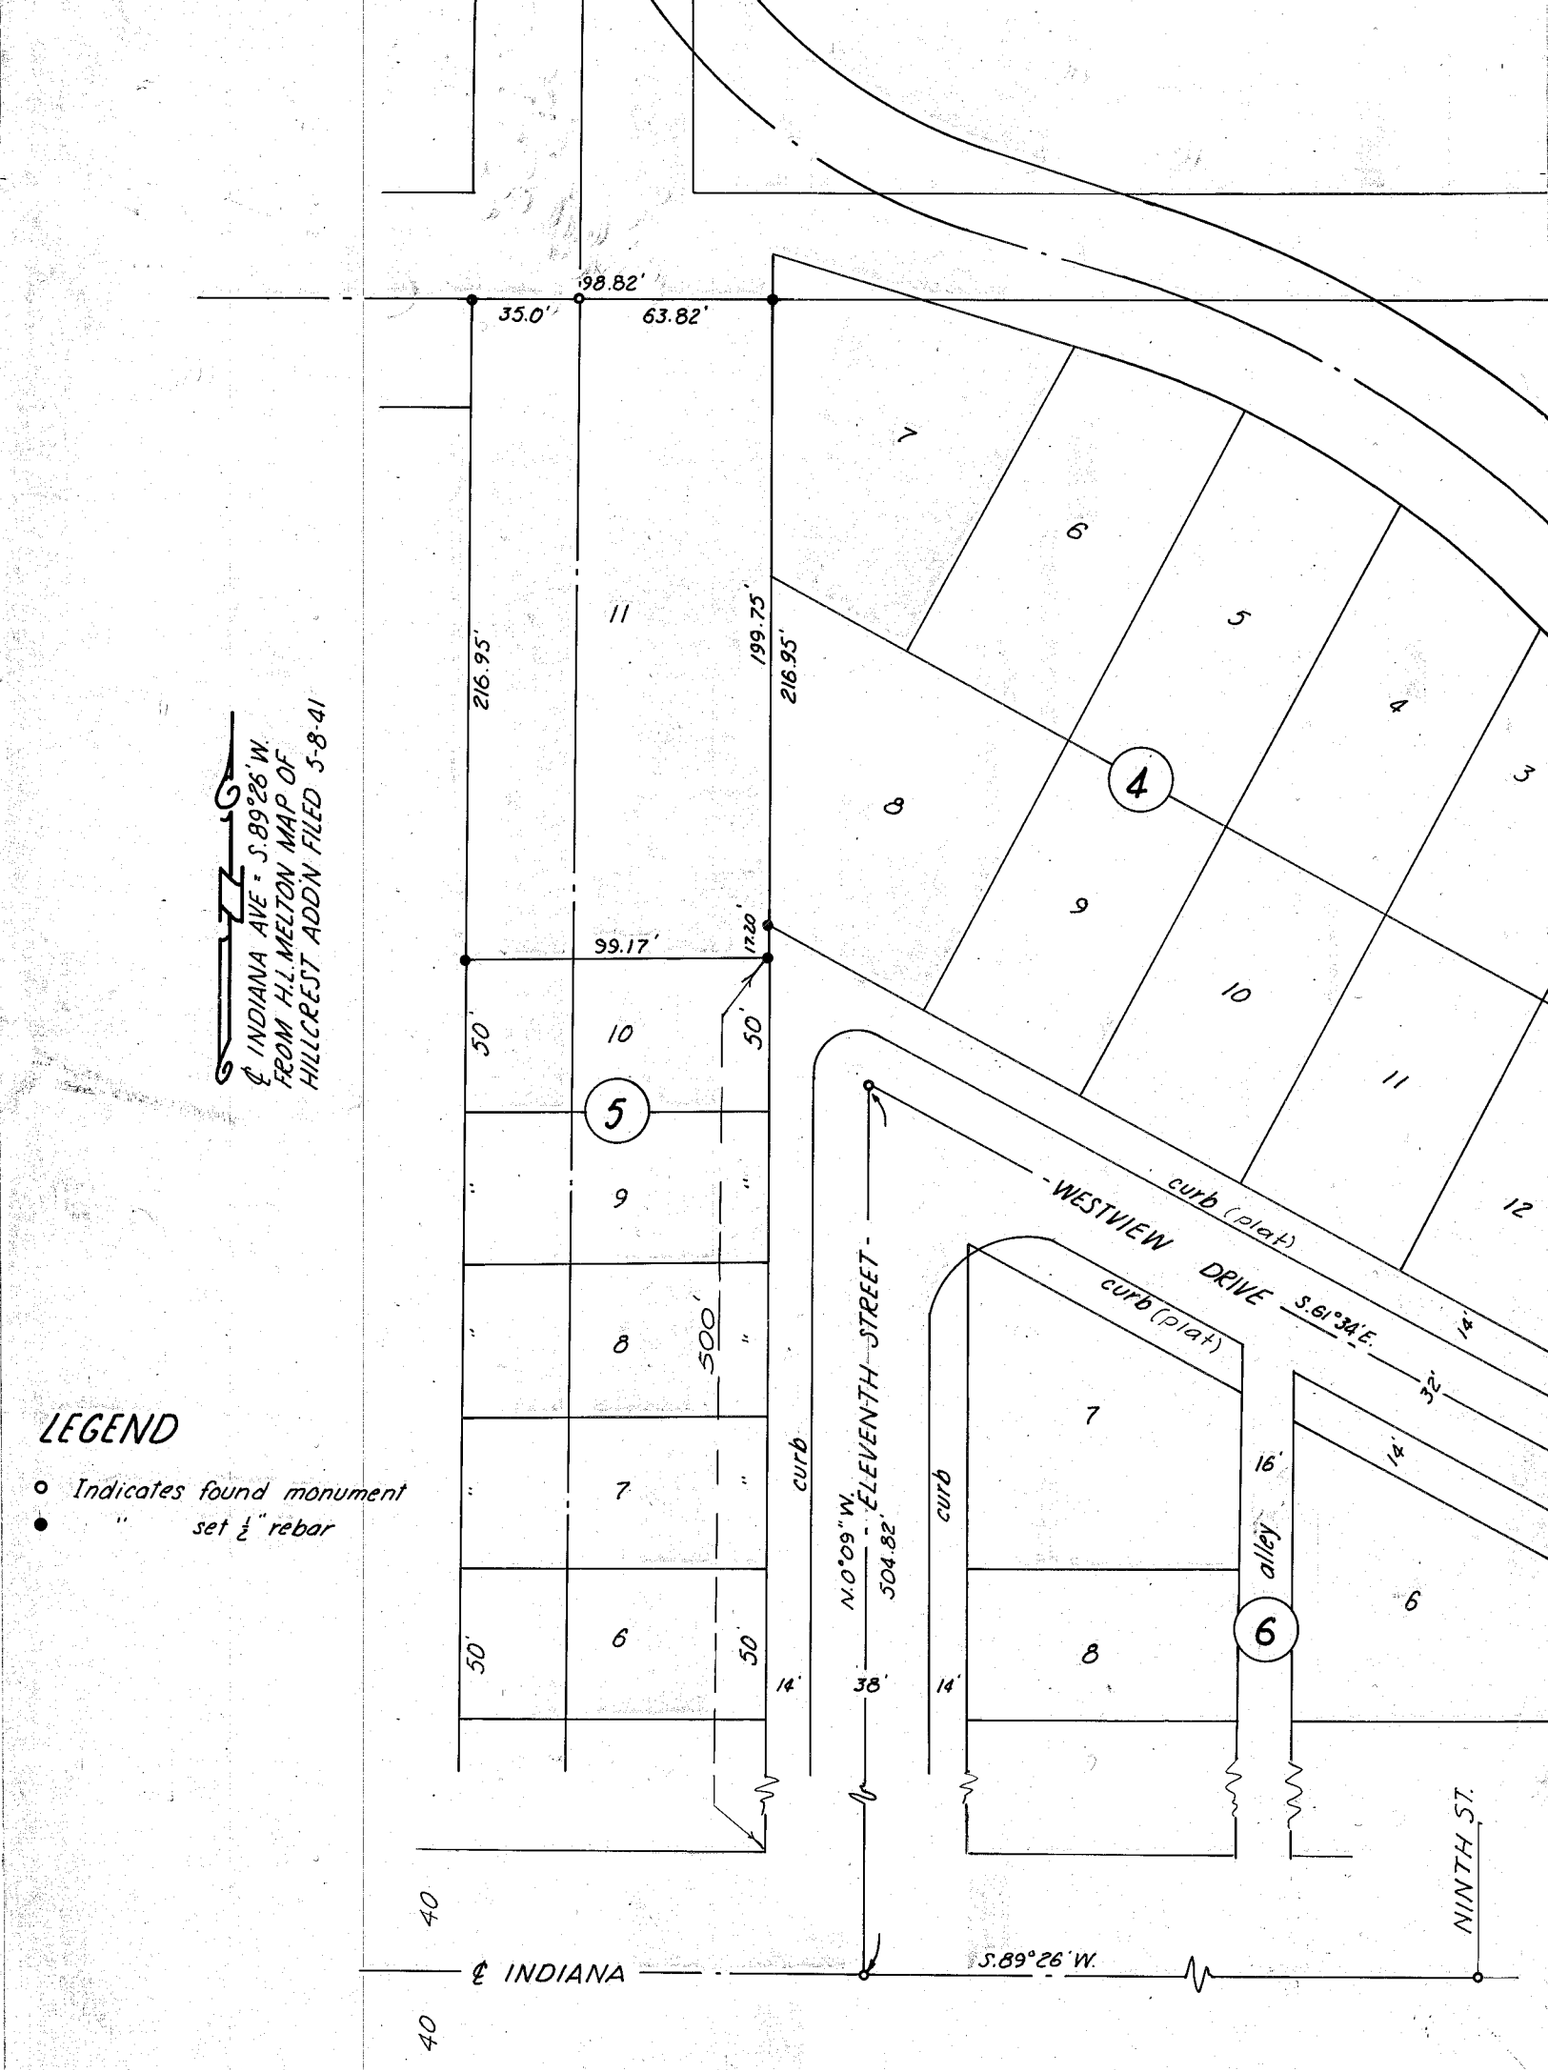


℄ INDIANA AVE - S.89°26'W. FROM H.L. MELTON MAP OF HILLCREST ADDN FILED 5-8-41

## LEGEND

- ○ Indicates found monument
- ● " set ½" rebar

# MAP OF SURVEY

## LOT 11, BLOCK 5, HILLCREST ADDITION TO BAKER, OREGON

Surveyed Feb. 11, 1976 Scale 1"=60'

For Norman Kolb

FILED Feb. 20, 1976

BAKER COUNTY SURVEYOR

SURVEY NO. 9-40-69 BC

REGISTERED PROFESSIONAL ENGINEER 2808 James D. Hanley OREGON May 7, 1948 JAMES D. HANLEY