

O.S.H.D. Meridian for $\frac{1}{4}$ Pocahontas Road, Drawing of August, 1953.

LEGEND

- Indicates found monument
- " set $\frac{1}{2}$ " rebar

UNION PACIFIC RAILROAD


(O.W.R. & N. Co)

N. 89° 46' 40" E.

POCAHONTAS ROAD

East $\frac{1}{4}$ cor. section 7
T. 9 S., R. 40 E., W.M.

CHICO (17th St.)

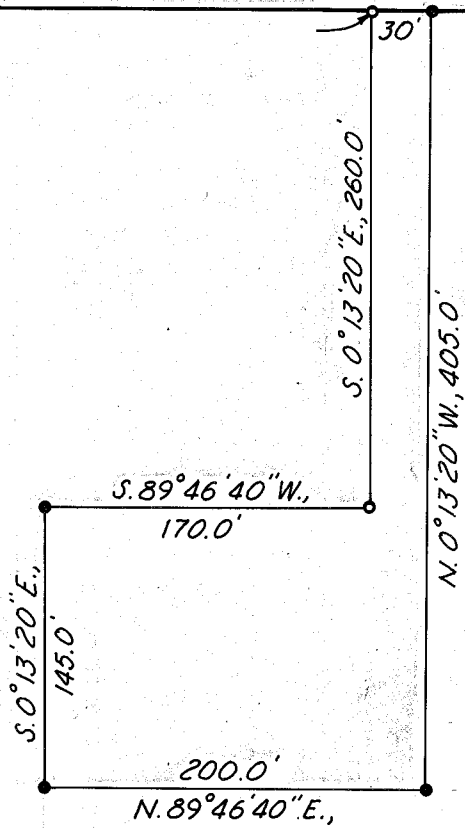

FILED Oct. 5, 1976
 BAKER COUNTY SURVEYOR
 SURVEY NO. 9-40-87 BC

MAP OF SURVEY
 A PARCEL IN THE NE $\frac{1}{4}$ NE $\frac{1}{4}$ SECTION 7,
 T. 9 S., R. 40 E., W.M. 5EVA
 September 10, 1976 Scale 1"=100'
 for Dick Hoynes

