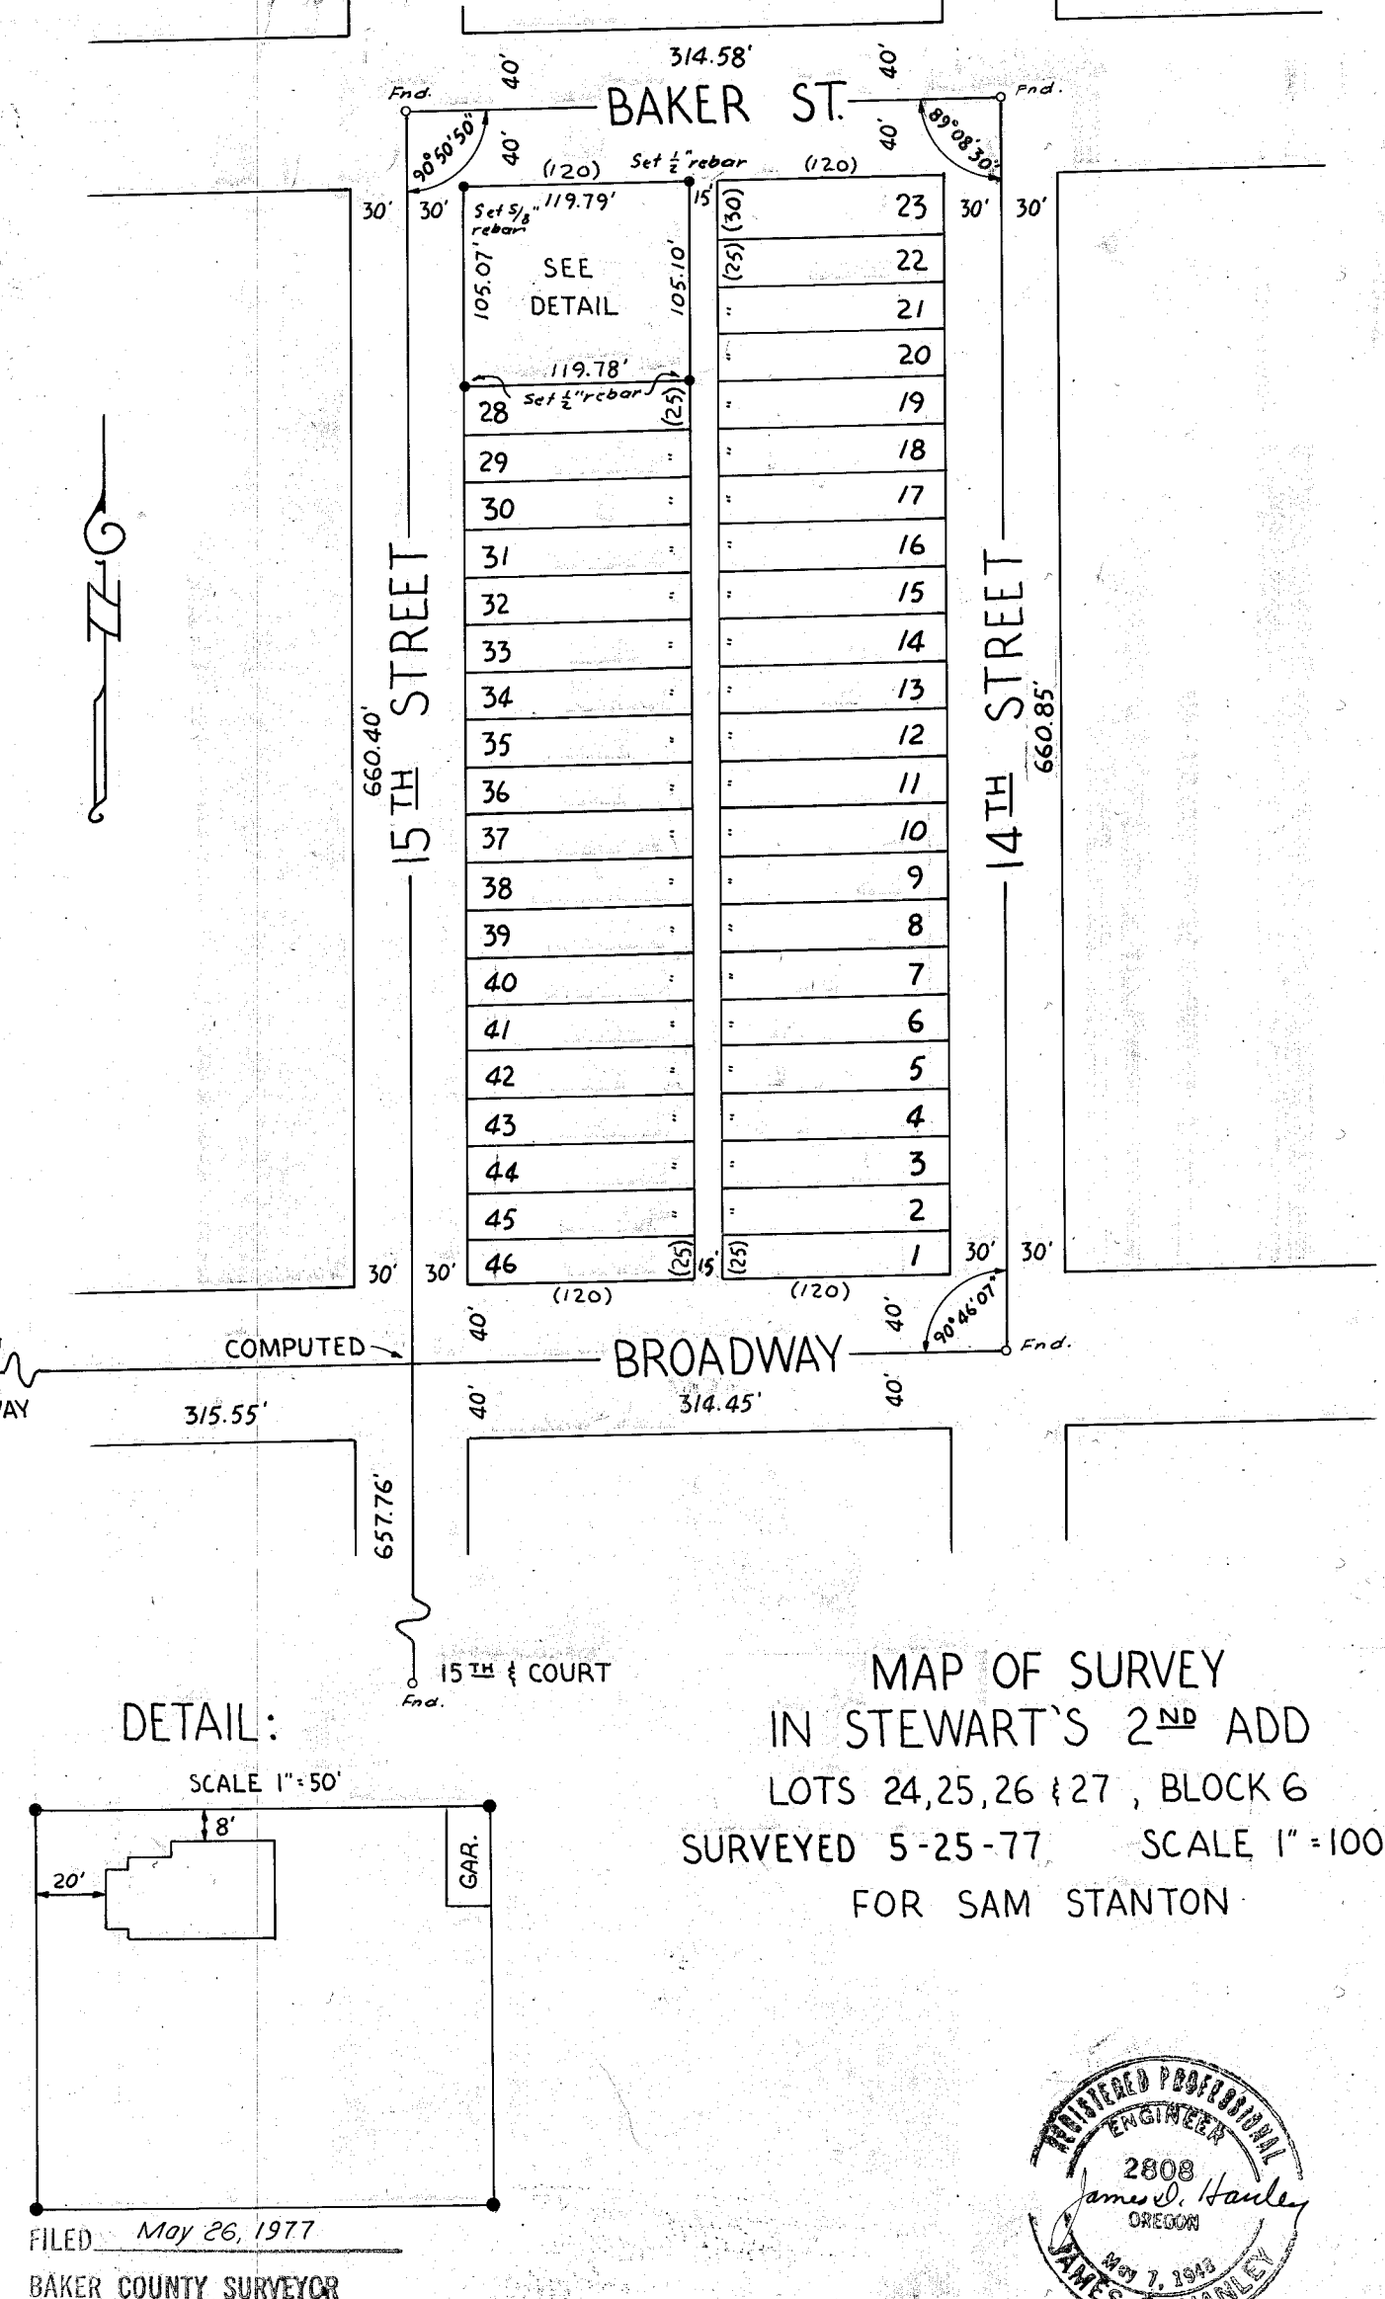

DETAIL:

SCALE 1" = 50'

MAP OF SURVEY
IN STEWART'S 2ND ADD
LOTS 24, 25, 26 & 27, BLOCK 6

SURVEYED 5-25-77 SCALE 1" = 100'

FOR SAM STANTON

REGISTERED PROFESSIONAL ENGINEER
2808
James D. Hanley
OREGON
May 7, 1943
JAMES D. HANLEY

FILED May 26, 1977

BAKER COUNTY SURVEYOR

SURVEY NO. 9-40-95 BC