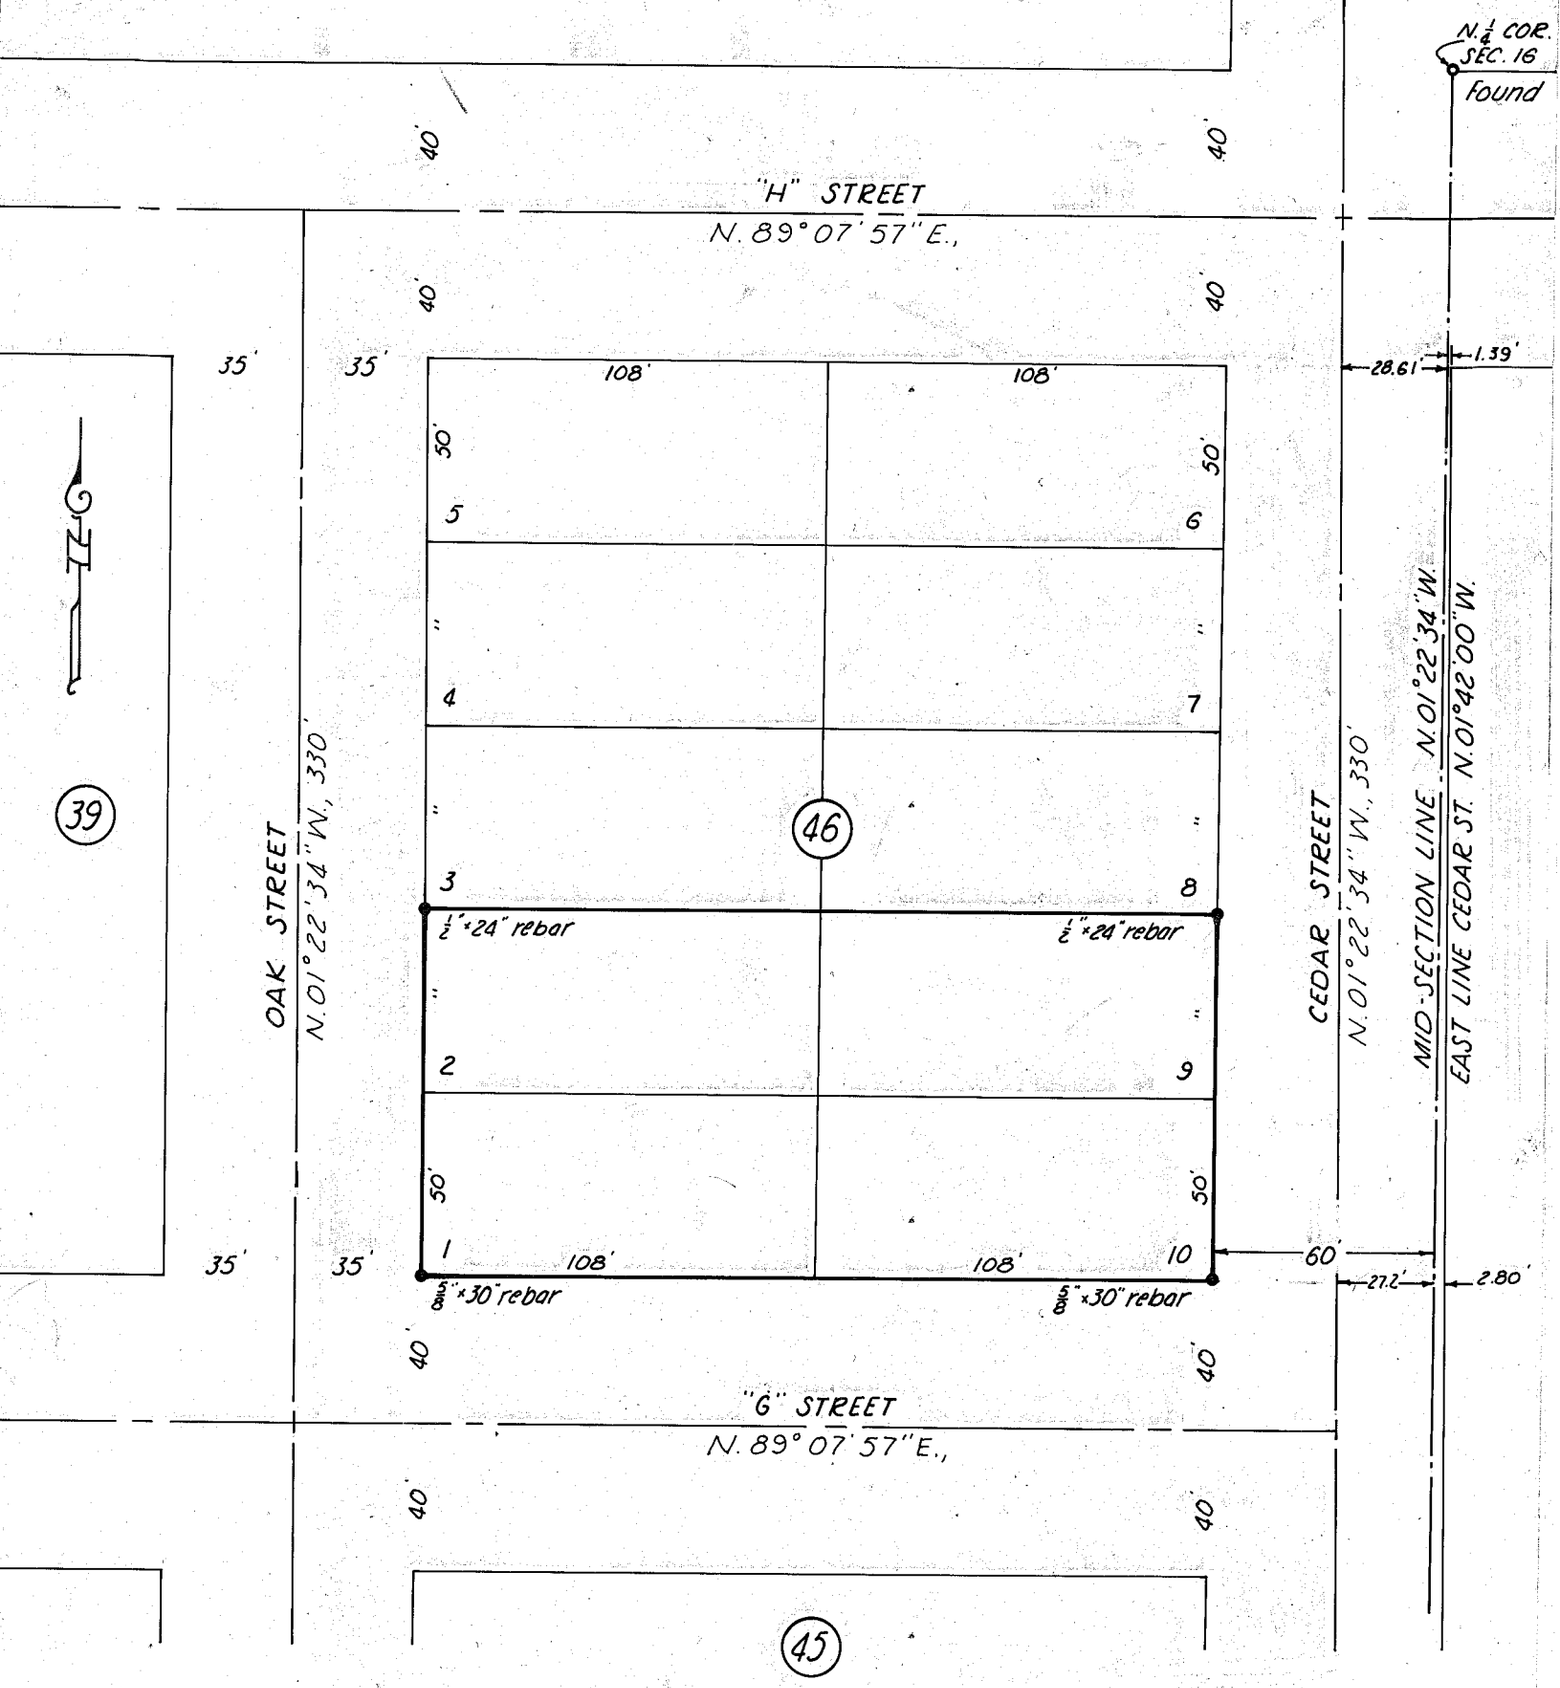

• Indicates set iron pin

MAP OF SURVEY

LOTS 1, 2, 9 & 10, BLOCK 46, MIX ADD'N TO BAKER, OREGON

Surveyed June 15, 1977 Scale 1" = 50'

For Harvey Ewing

REGISTERED PROFESSIONAL ENGINEER 2808 James D. Hanley OREGON May 1, 1948 JAMES D. HANLEY

FILED July 5, 1977

BAKER COUNTY SURVEYOR

SURVEY NO. 9-40-100 BC