


LEGEND

- Indicates set $\frac{1}{2}$ " rebar unless otherwise noted
- ◻ " found mon. in box
- " found mon. as noted

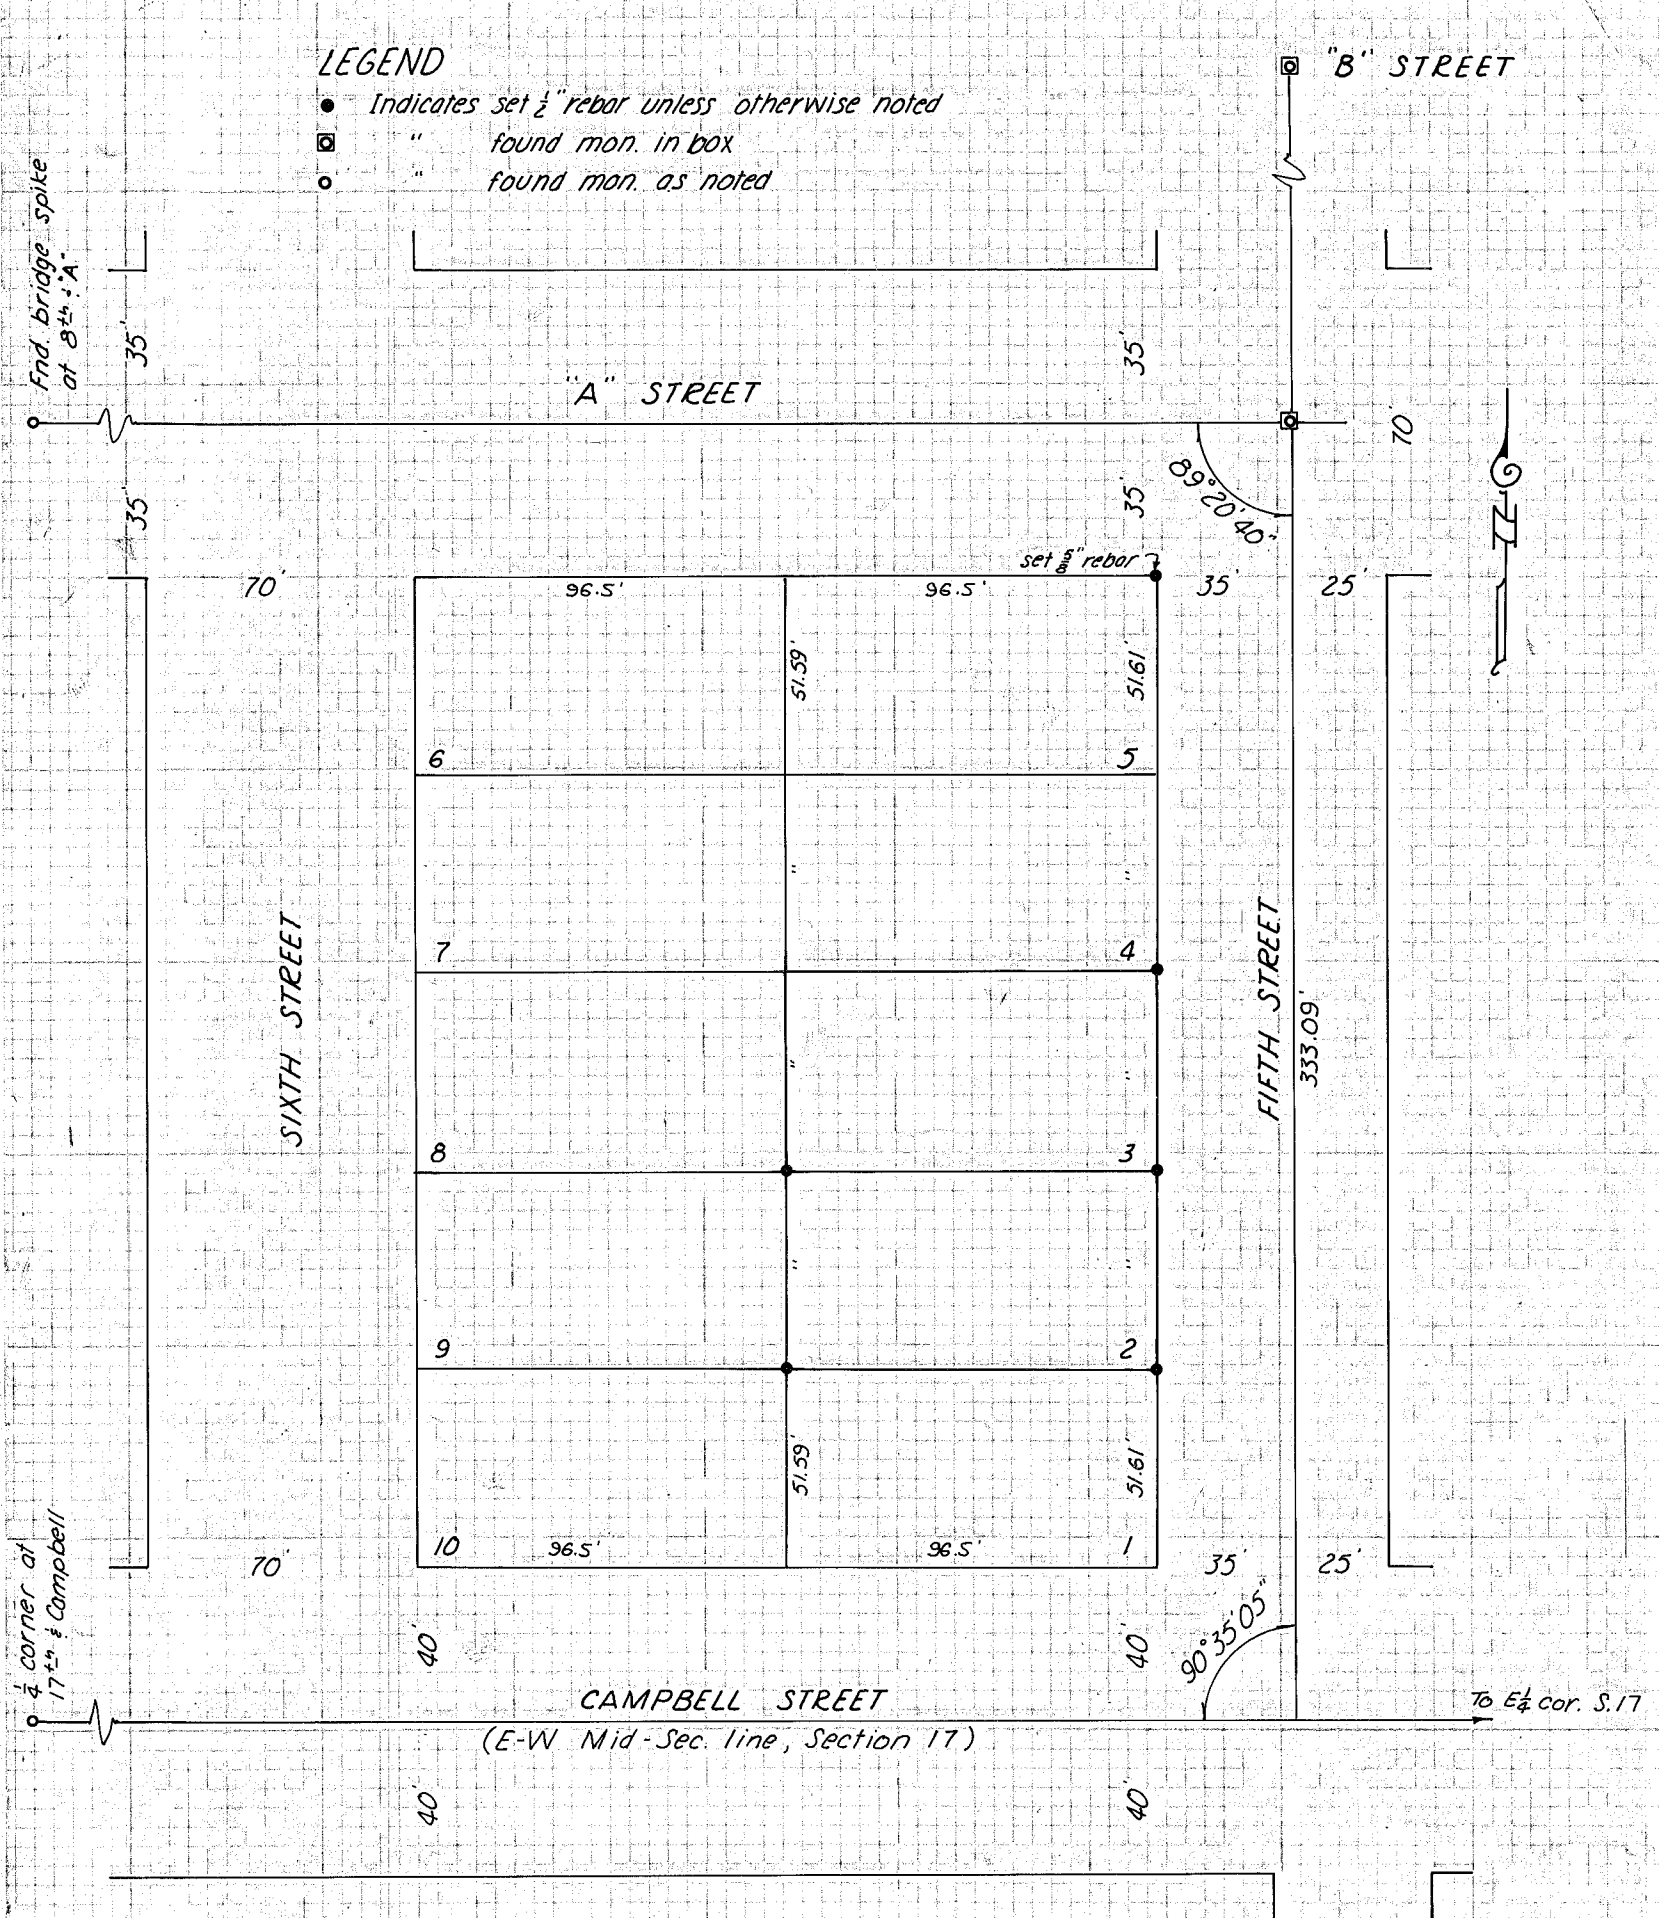


**MAP OF SURVEY
LOTS 2 & 3, BLOCK 8, BRATTAIN & McCOMAS
ADDITION TO BAKER, ORE.**

Surveyed April 6 - July 15, 1977

Scale 1" = 50'

For Sid Johnson

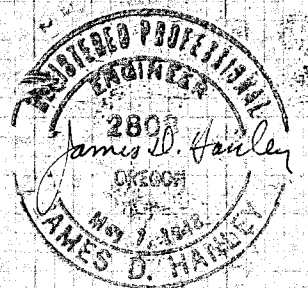

FILED July 16, 1977

BAKER COUNTY SURVEYOR

SURVEY NO. 7-40-101 BC