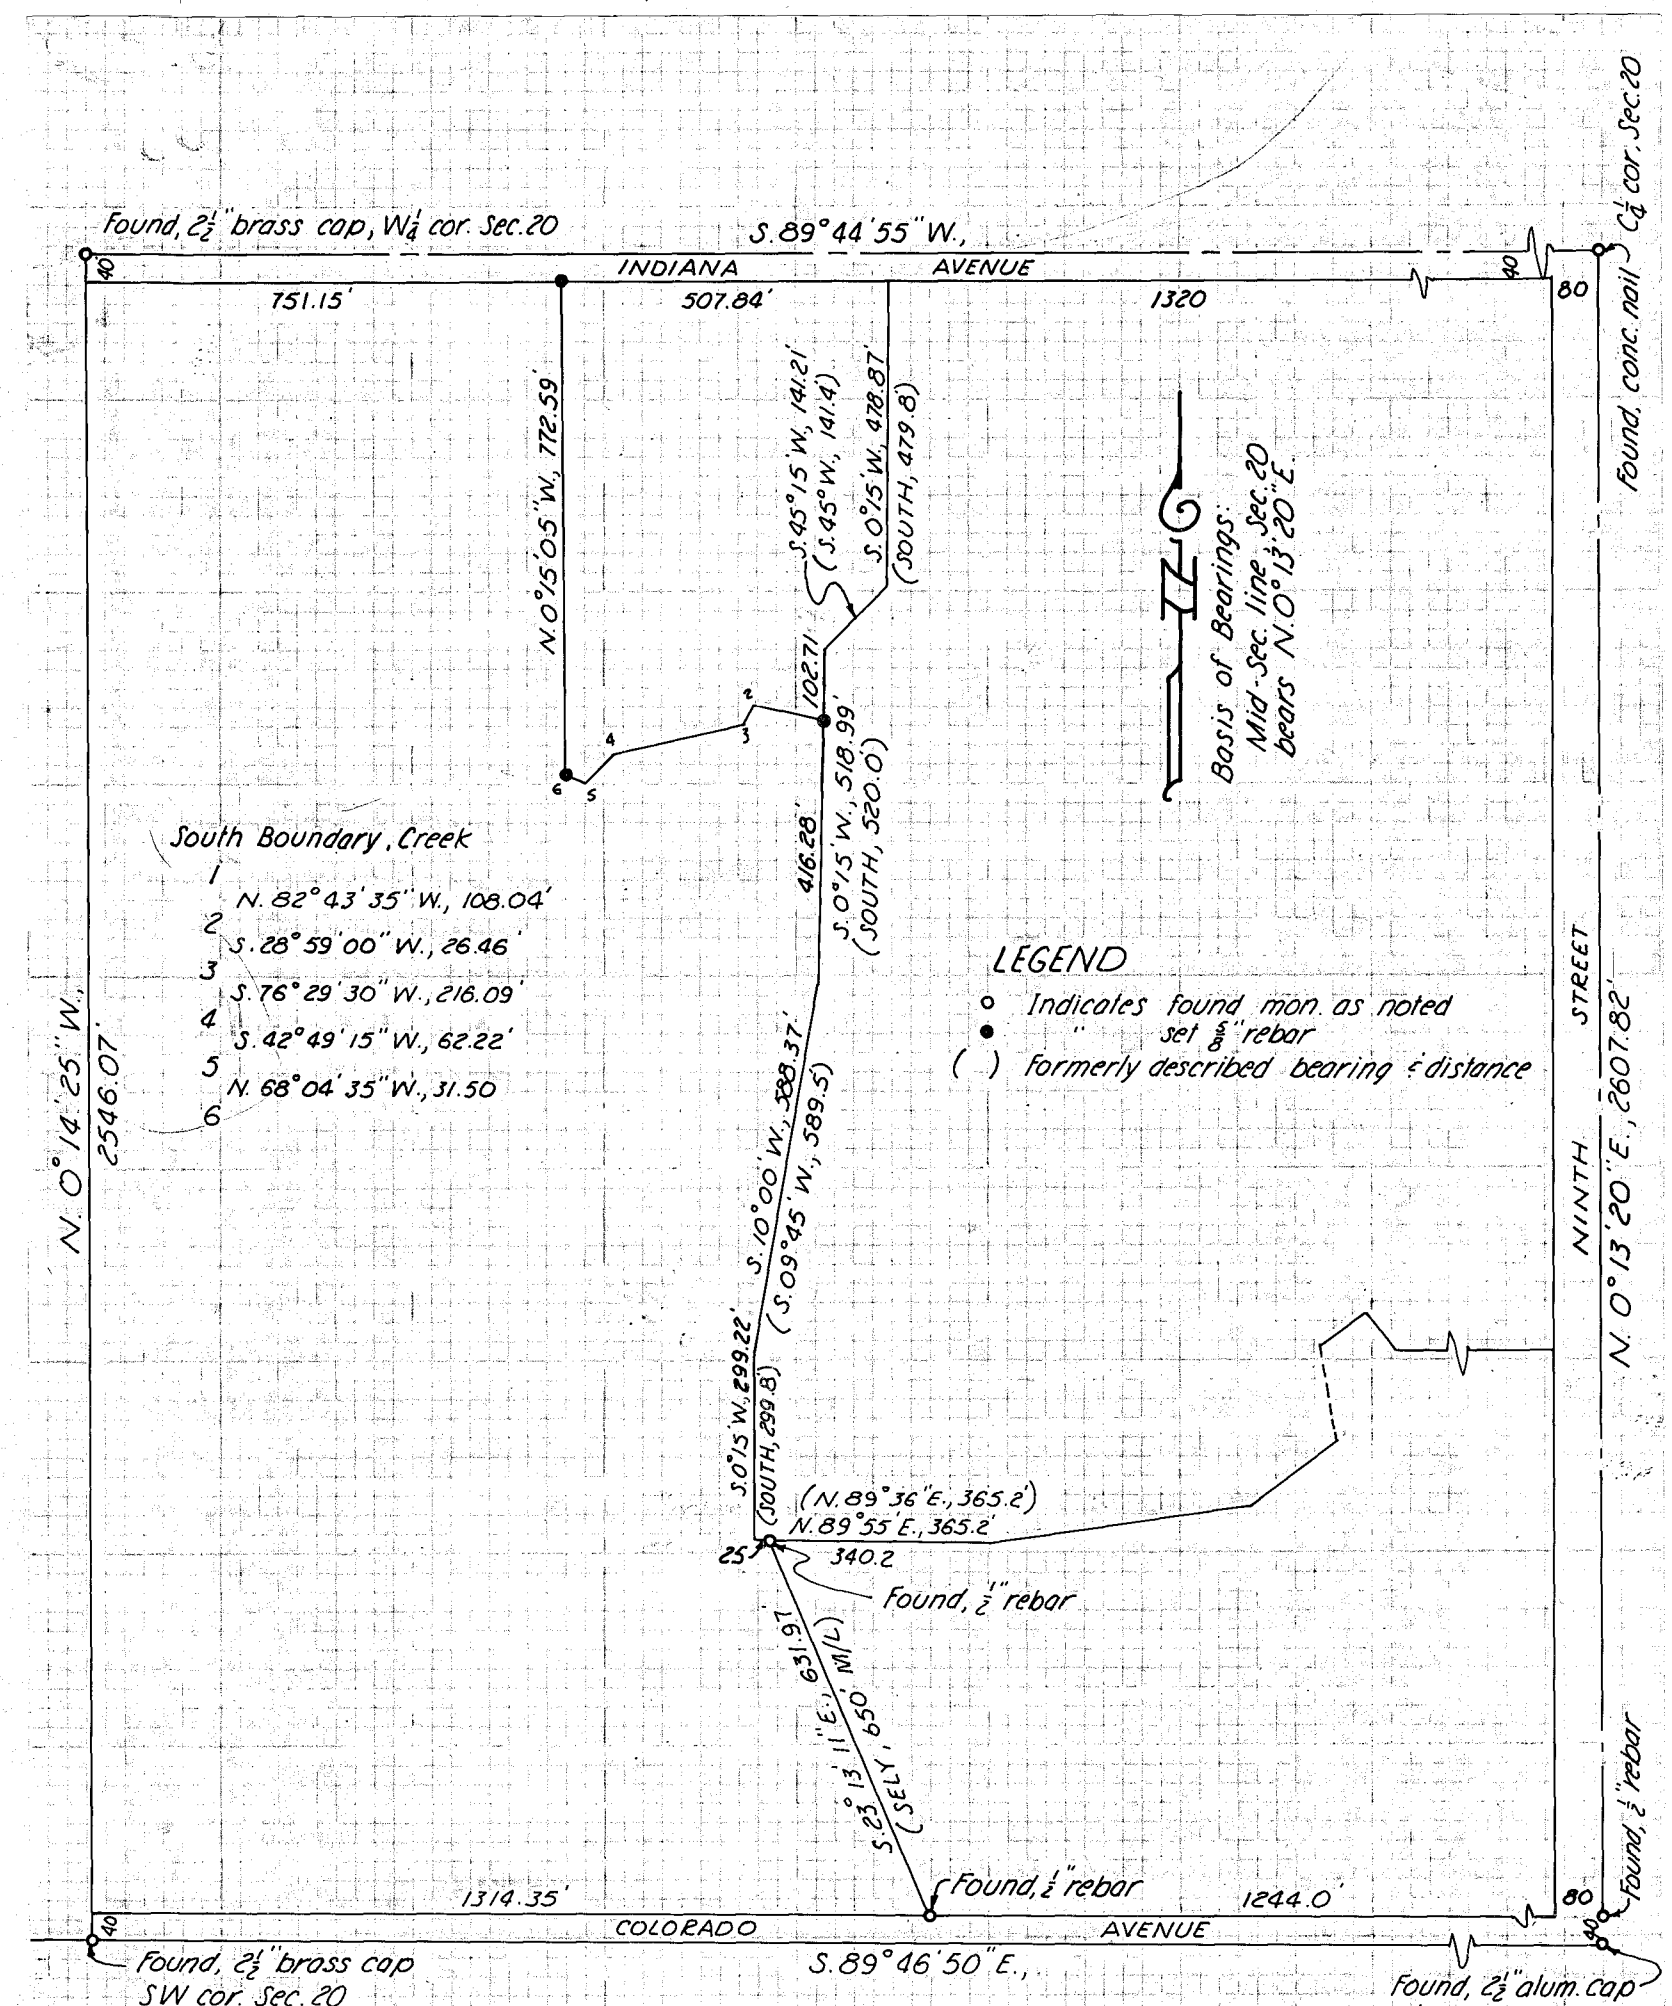

MAP OF SURVEY

A PARCEL IN THE SW¼ SECTION 20

T. 9 S., R. 40 E., W. M.

Surveyed Aug. 8 & 11, 1977 Scale 1" = 300'

for Ollie Beeson

REGISTERED PROFESSIONAL ENGINEER
2808
James D. Hanley
OREGON
May 7, 1948
JAMES D. HANLEY

FILED Aug. 12, 1977

BAKER COUNTY SURVEYOR

SURVEY NO. 9 - 40 - 107