


Note: 10' of streets vacated by
Ord. 2668, Deed 73-32-029.

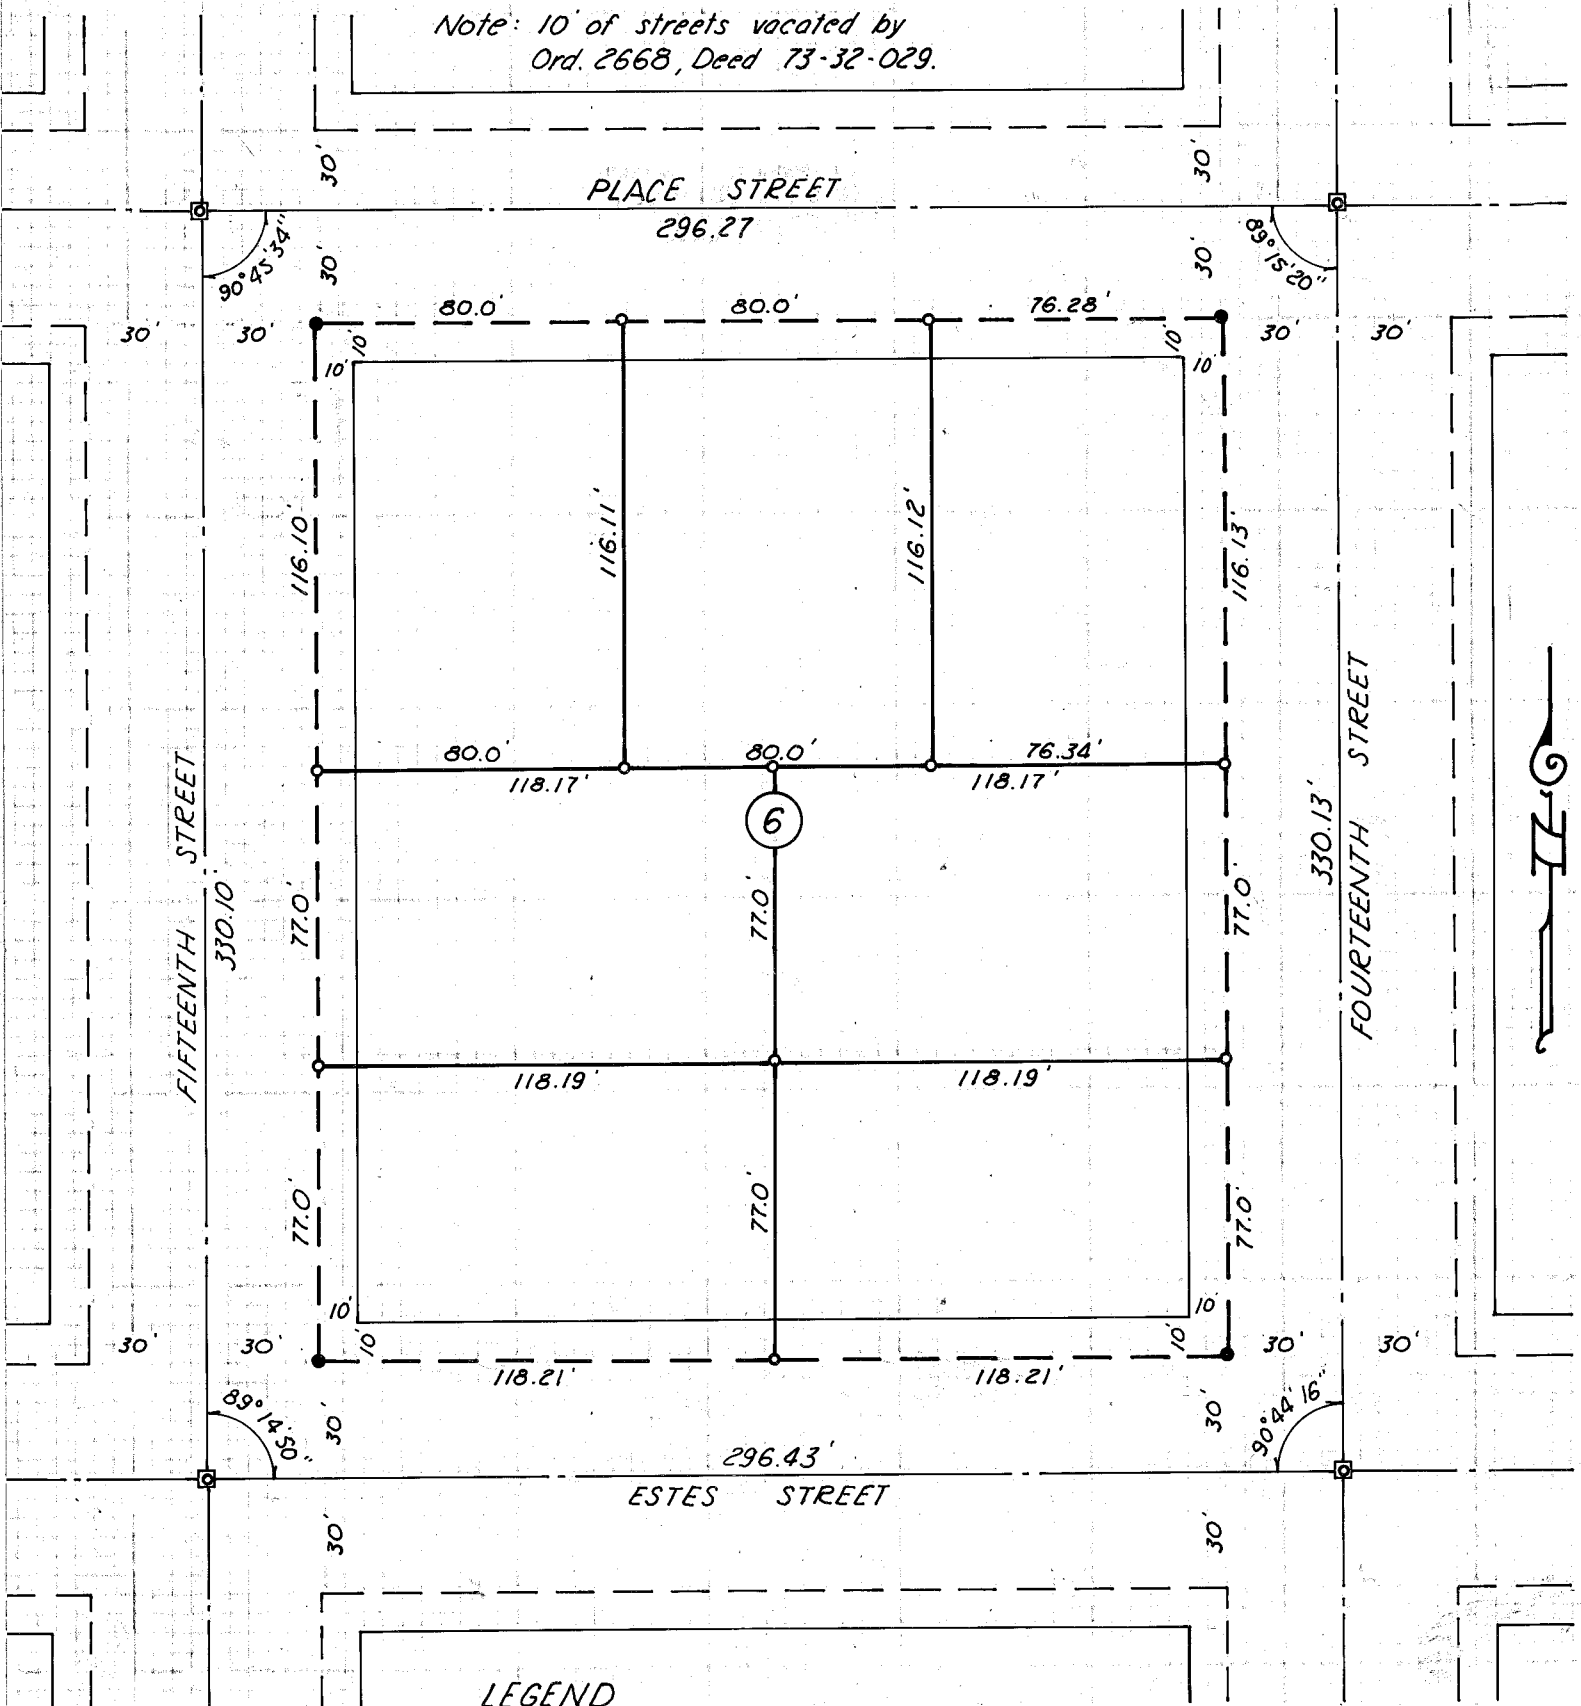

LEGEND

- ☐ Found, City mon. in box
- Set $\frac{5}{8}$ " x 30" rebar
- Set $\frac{1}{2}$ " x 24" rebar

MAP OF SURVEY
BLOCK 6, KELLOGG'S ADDITION
TO BAKER, ORE.

Surveyed March 7 & 8, 1978 Scale 1"=50'

For Laurin M. Davis

FILED March 13, 1978

BAKER COUNTY SURVEYOR

SURVEY NO. 7-40-115 BC

REGISTERED
PROFESSIONAL
LAND SURVEYOR

James D. Hanley

OREGON
SEPTEMBER 23, 1977
JAMES D. HANLEY
1206