Found monument marking intersection of E. line Main St. and N. line "D" St. and a monument marking centerline of College St., 40' N. of centerline "D" St. Reestablished centerline of "D" St. 40' S. of line connecting these monuments. No monuments found between these points on "D" Street centerline.

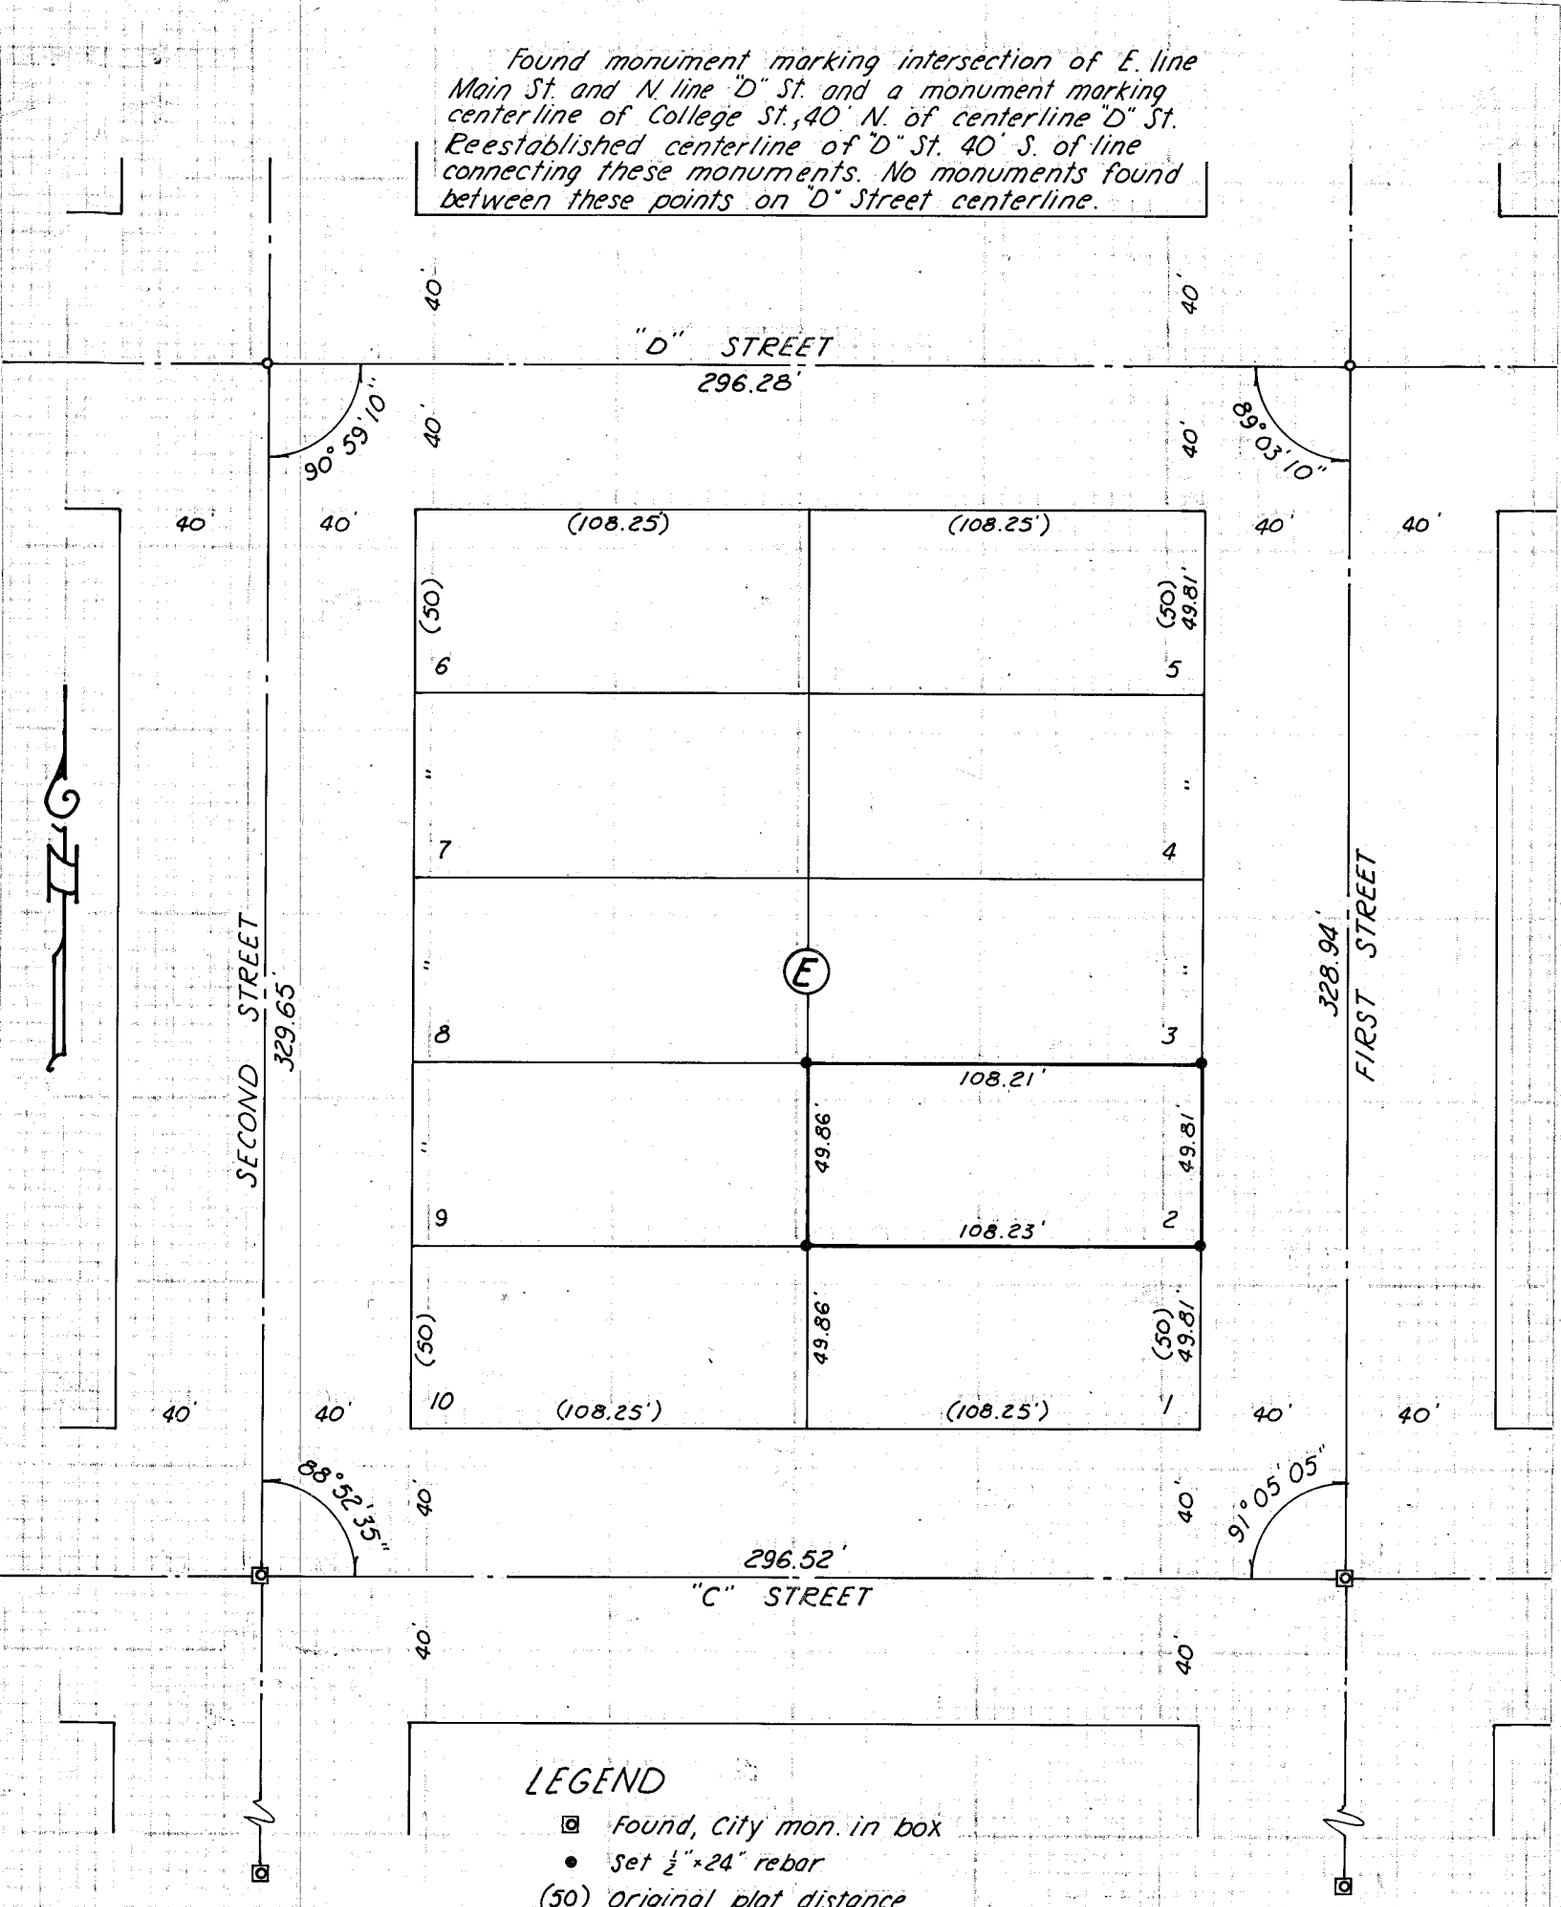

LEGEND

- ⊡ Found, City mon. in box
- • Set ½"×24" rebar
- (50) Original plat distance

MAP OF SURVEY

LOT 2, BLOCK E, FATHER DE ROO'S ADDITION TO BAKER, ORE.

Surveyed March 9 & 10, 1978 Scale 1"=50'

For Barry Hogge

FILED March 13, 1978
BAKER COUNTY SURVEYOR
SURVEY NO. 9-40-116 BC

REGISTERED PROFESSIONAL LAND SURVEYOR
James D. Hanley
OREGON
SEPTEMBER 23, 1977
JAMES D. HANLEY
1206